
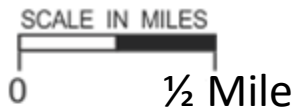


“G”

Graphics
Staglin Family Vineyards Major
Modification
P18-00253-MOD

NAPA COUNTY LAND USE PLAN 2008 – 2030

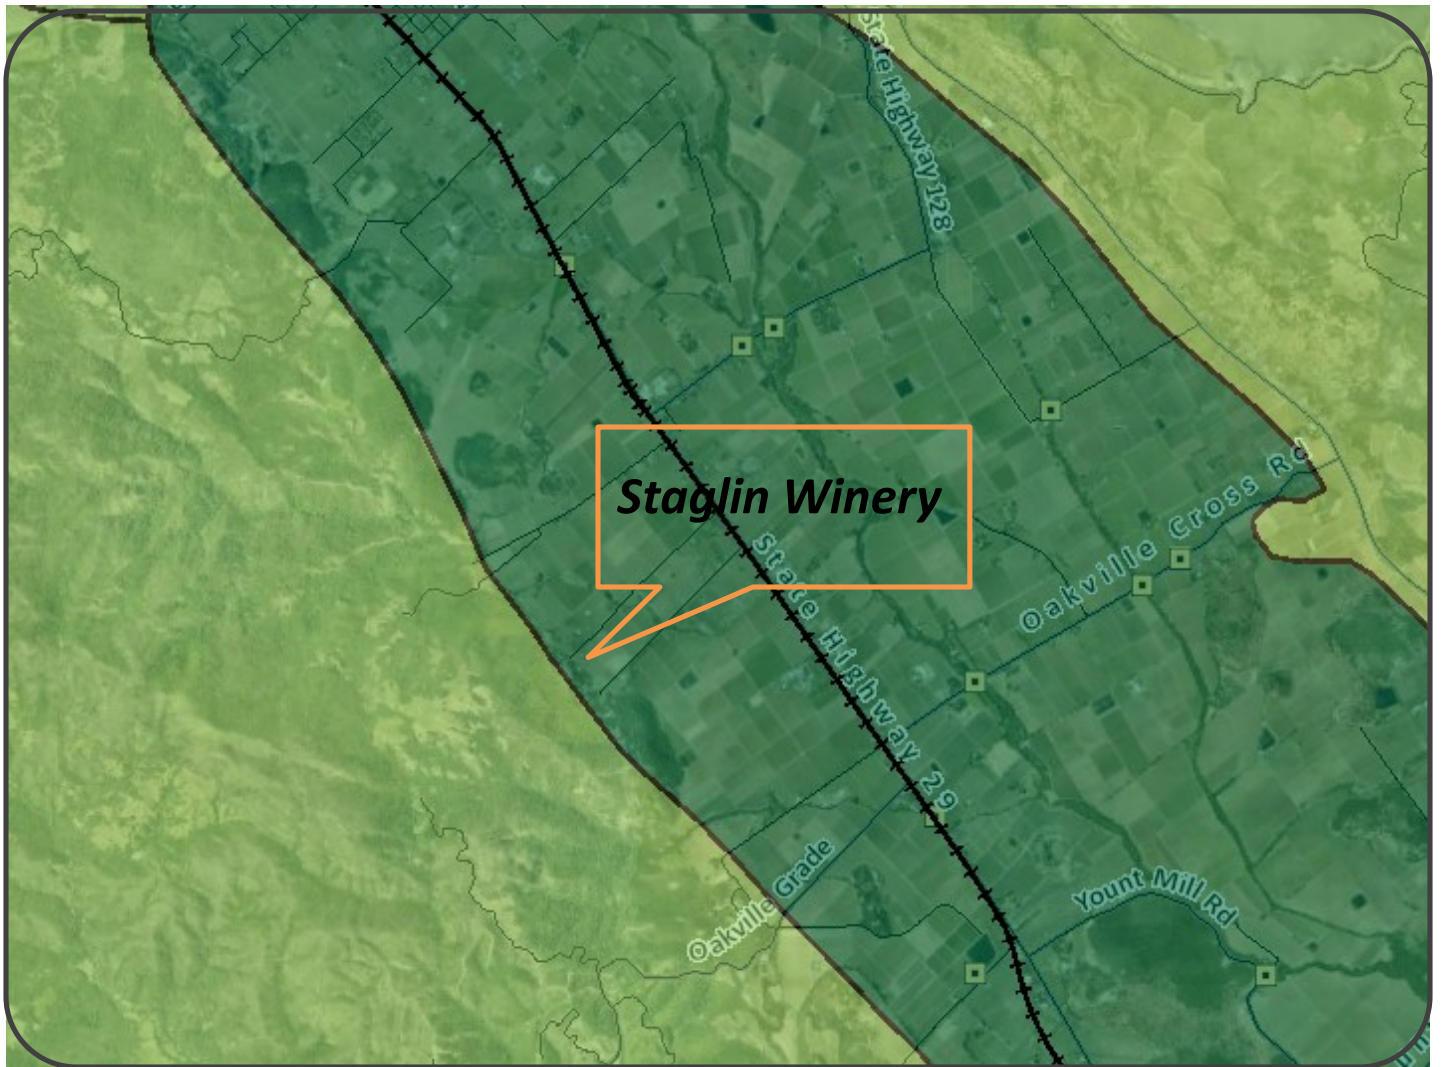

LEGEND



URBANIZED OR NON-AGRICULTURAL

- Study Area
- Cities
- Urban Residential*
- Rural Residential*
- Industrial
- Public-Institutional


OPEN SPACE

- Agriculture, Watershed & Open Space
- Agricultural Resource

TRANSPORTATION

- Mineral Resource
- Limited Access Highway
- American Canyon ULL
- City of Napa RUL
- Landfill - General Plan
- Road
- Airport
- Railroad
- Airport Clear Zone

* See Action Item AG/LU-114.1 regarding agriculturally zoned areas within these land use designations

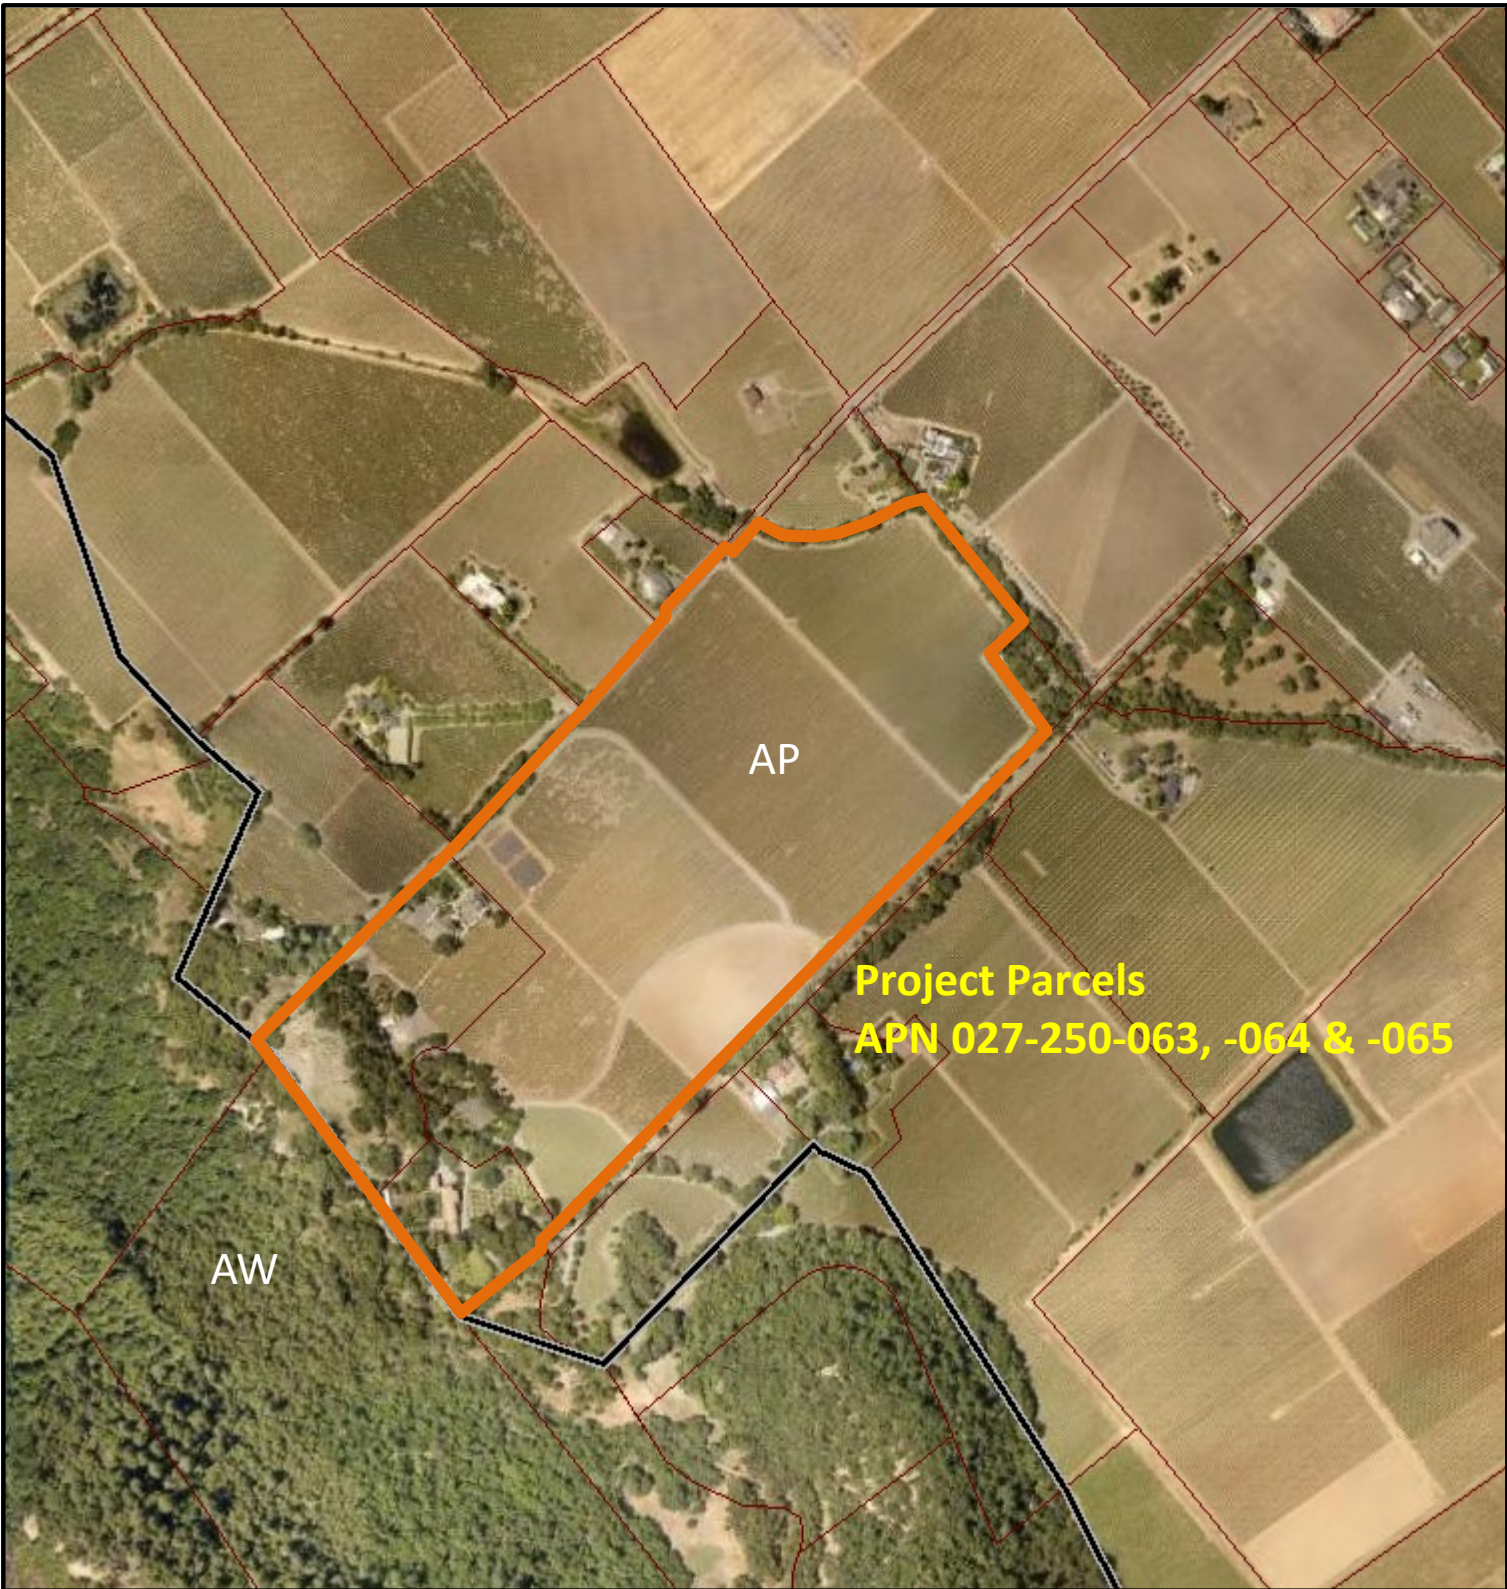

LEGEND

- Zoning
- Parcels




ZONING MAP



Existing Conditions

THIS DOCUMENT, AND THE IDEAS AND DESIGNS INCORPORATED HEREIN, IS THE PROPERTY OF SUMMIT ENGINEERING, INC. AND IS NOT TO BE USED IN WHOLE OR IN PART, FOR ANY OTHER PROJECT WITHOUT THE WRITTEN AUTHORIZATION OF SUMMIT ENGINEERING, INC.

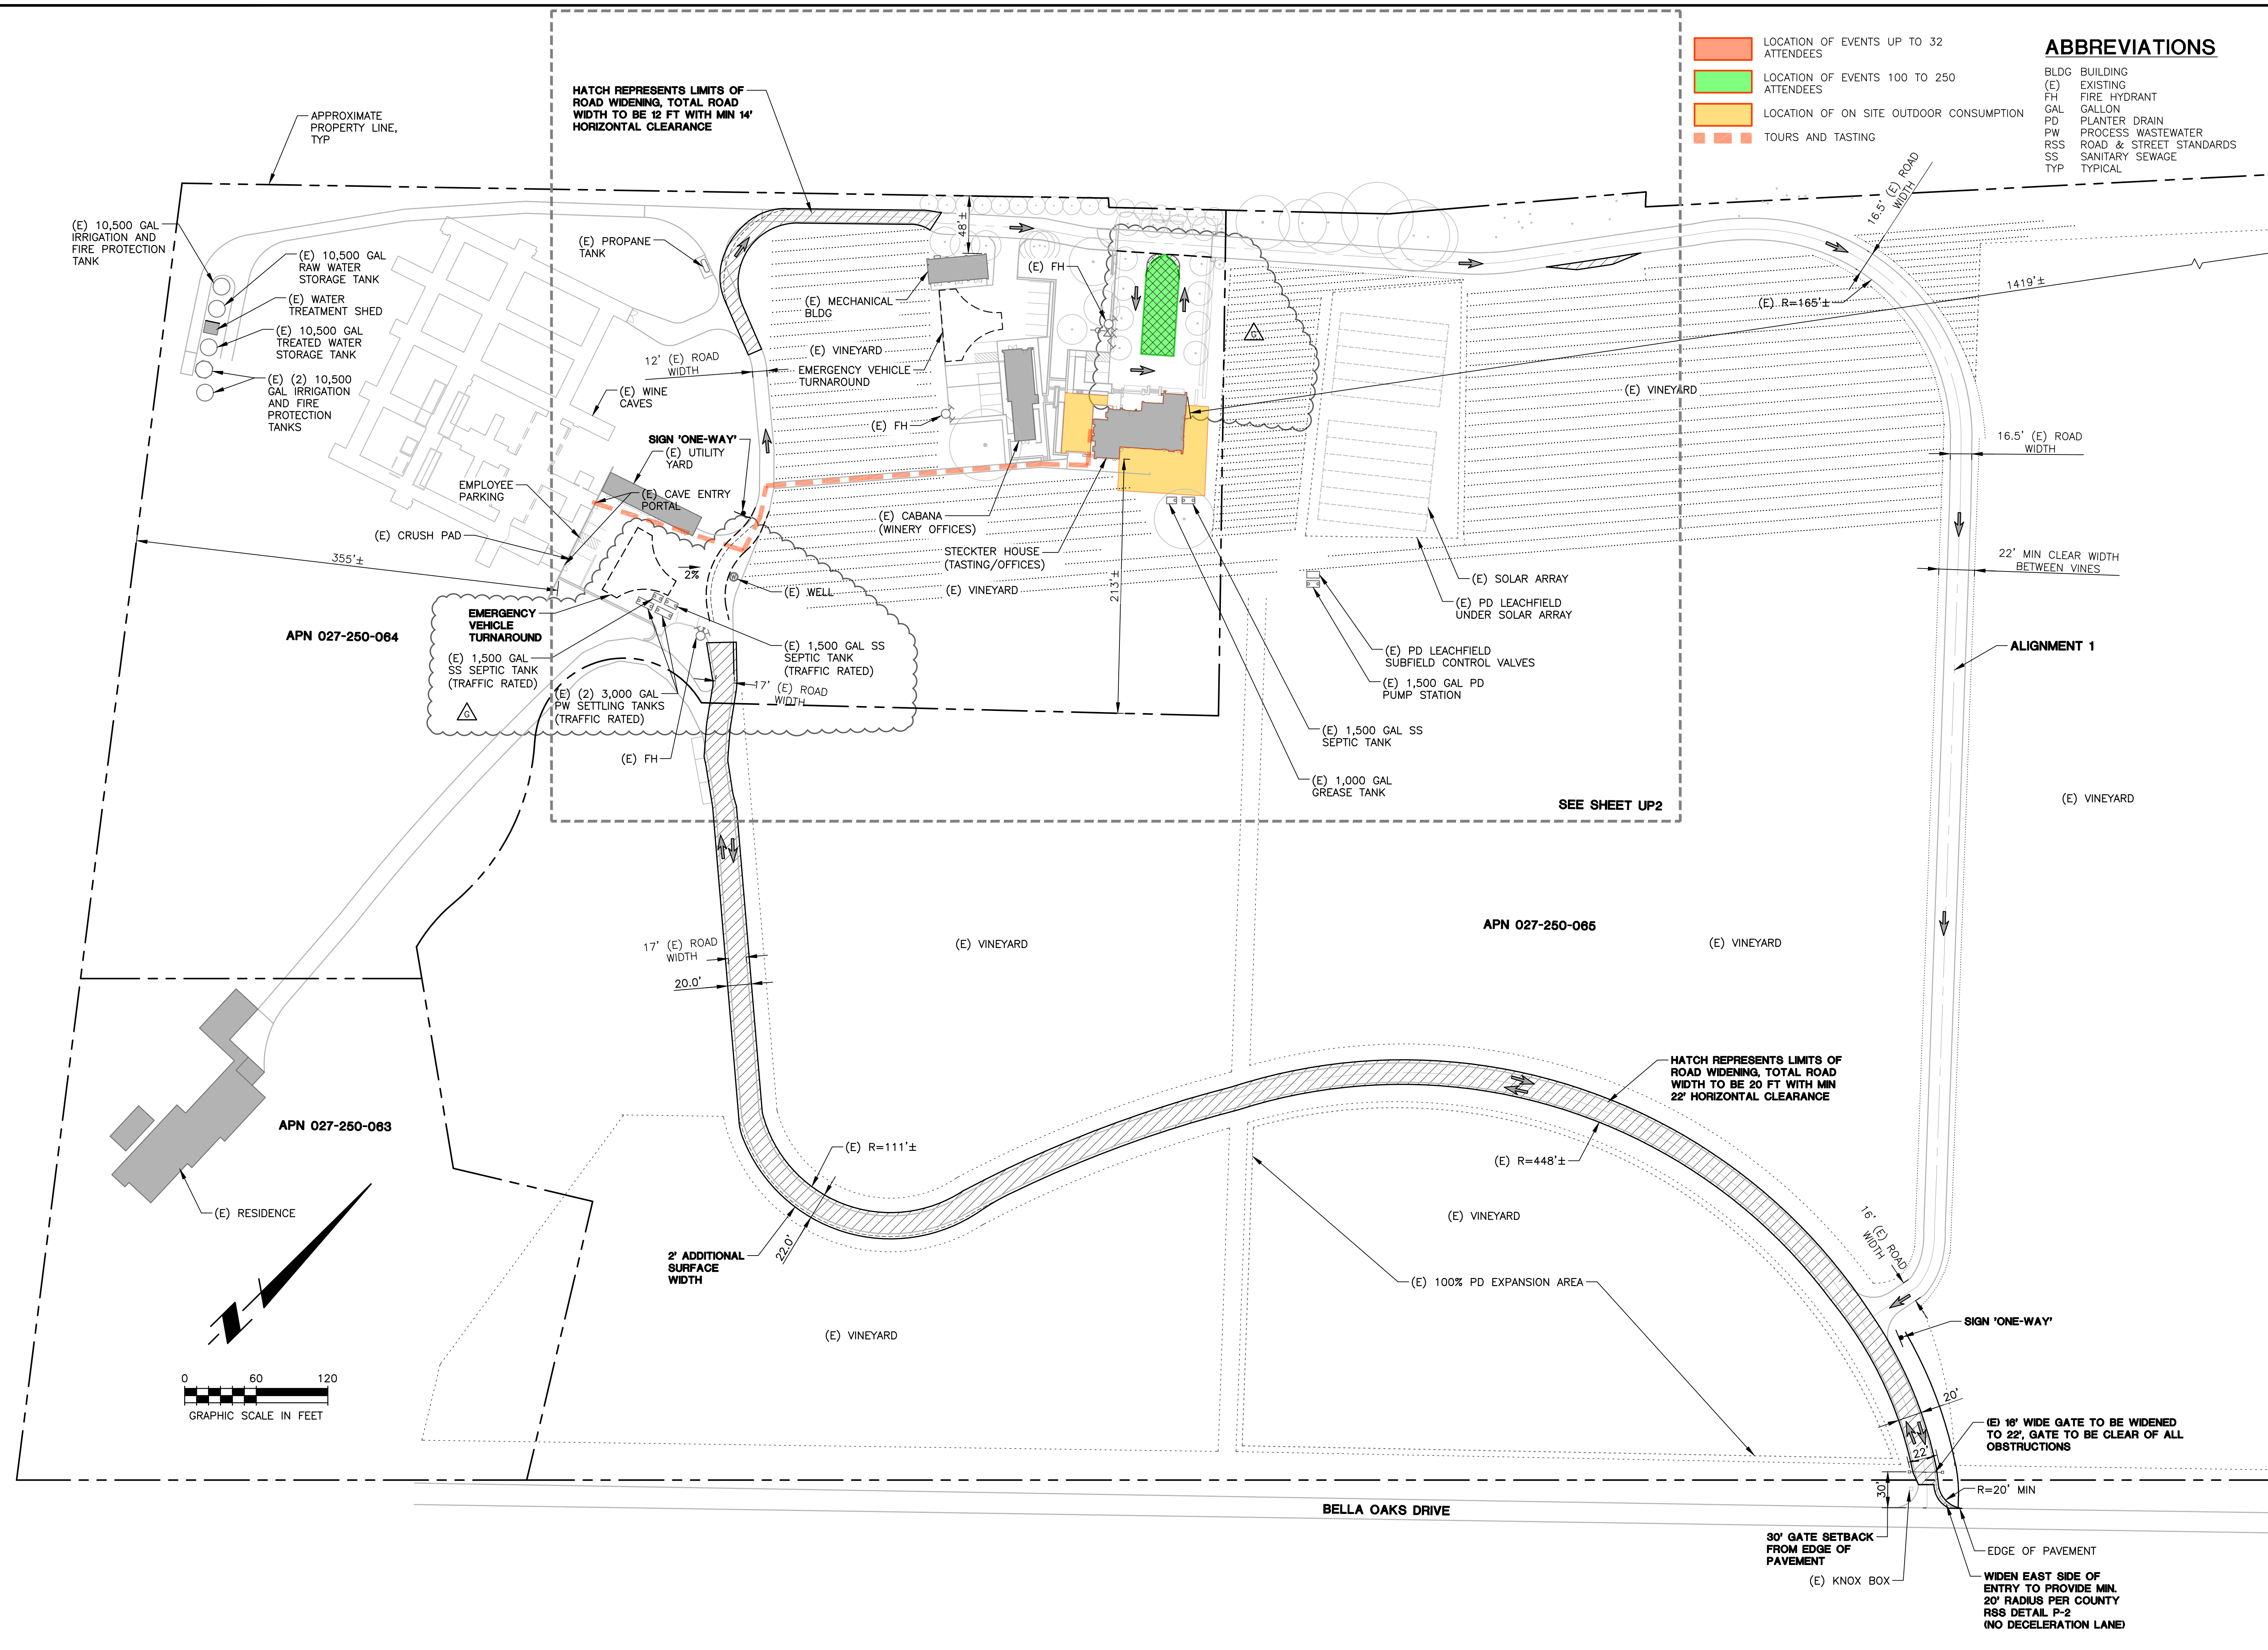

- LOCATION OF EVENTS UP TO 32 ATTENDEES
- LOCATION OF EVENTS 100 TO 250 ATTENDEES
- LOCATION OF ON SITE OUTDOOR CONSUMPTION
- TOURS AND TASTING

ABBREVIATIONS

BLDG	BUILDING
(E)	EXISTING
FH	FIRE HYDRANT
GAL	GALLON
PD	PLANTER DRAIN
PW	PROCESS WASTEWATER
RSS	ROAD & STREET STANDARDS
SS	SANITARY SEWAGE
TYP	TYPICAL

SUMMIT
 Summit Engineering, Inc.
 463 Aviation Blvd., Suite 200 • Santa Rosa, CA 95403
 707-527-0775 • www.summit-sr.com

STAGLIN FAMILY VINEYARD
 1570 BELLA OAKS LANE
 RUTHERFORD, CA
 APN 027-250-084, & 085

USE PERMIT MODIFICATIONS

OVERALL SITE PLAN

A	2019-01-29 PERMIT RESUBMITTAL
C	2019-07-26 PLAN CHECK RESPONSE
D	2020-05-11 CLIENT REVIEW
E	2020-06-02 PERMIT RESUBMITTAL
F	2020-09-22 PERMIT RESUBMITTAL
G	2020-09-22 PERMIT RESUBMITTAL

DATE: 2018-06-07
 JOB NO: 2018041
 SCALE: AS SHOWN
 DRAWN: TF
 CHECKED: RP
 SHEET


UP1

THIS DOCUMENT, AND THE IDEAS AND DESIGNS INCORPORATED HEREIN, AS AN INSTRUMENT OF PROFESSIONAL SERVICE, IS THE PROPERTY OF SUMMIT ENGINEERING, INC. AND IS NOT TO BE USED IN WHOLE OR IN PART, FOR ANY OTHER PROJECT WITHOUT THE WRITTEN AUTHORIZATION OF SUMMIT ENGINEERING, INC.

NOTE: ALL PARTS OF THE FIRE APPARATUS ACCESS ROAD AND STAGING AREA TO REMAIN UNOBSTRUCTED AT ALL TIMES.

- LOCATION OF EVENTS UP TO 32 ATTENDEES
- LOCATION OF EVENTS 100 TO 250 ATTENDEES
- LOCATION OF ON SITE OUTDOOR CONSUMPTION
- TOURS AND TASTING

- ABBREVIATIONS**
- BLDG BUILDING
 - (E) EXISTING
 - FH FIRE HYDRANT
 - GAL GALLON
 - PD PLANTER DRAIN
 - PW PROCESS WASTEWATER
 - R RADIUS
 - RSS ROAD & STREET STANDARDS
 - SS SANITARY SEWAGE
 - TYP TYPICAL

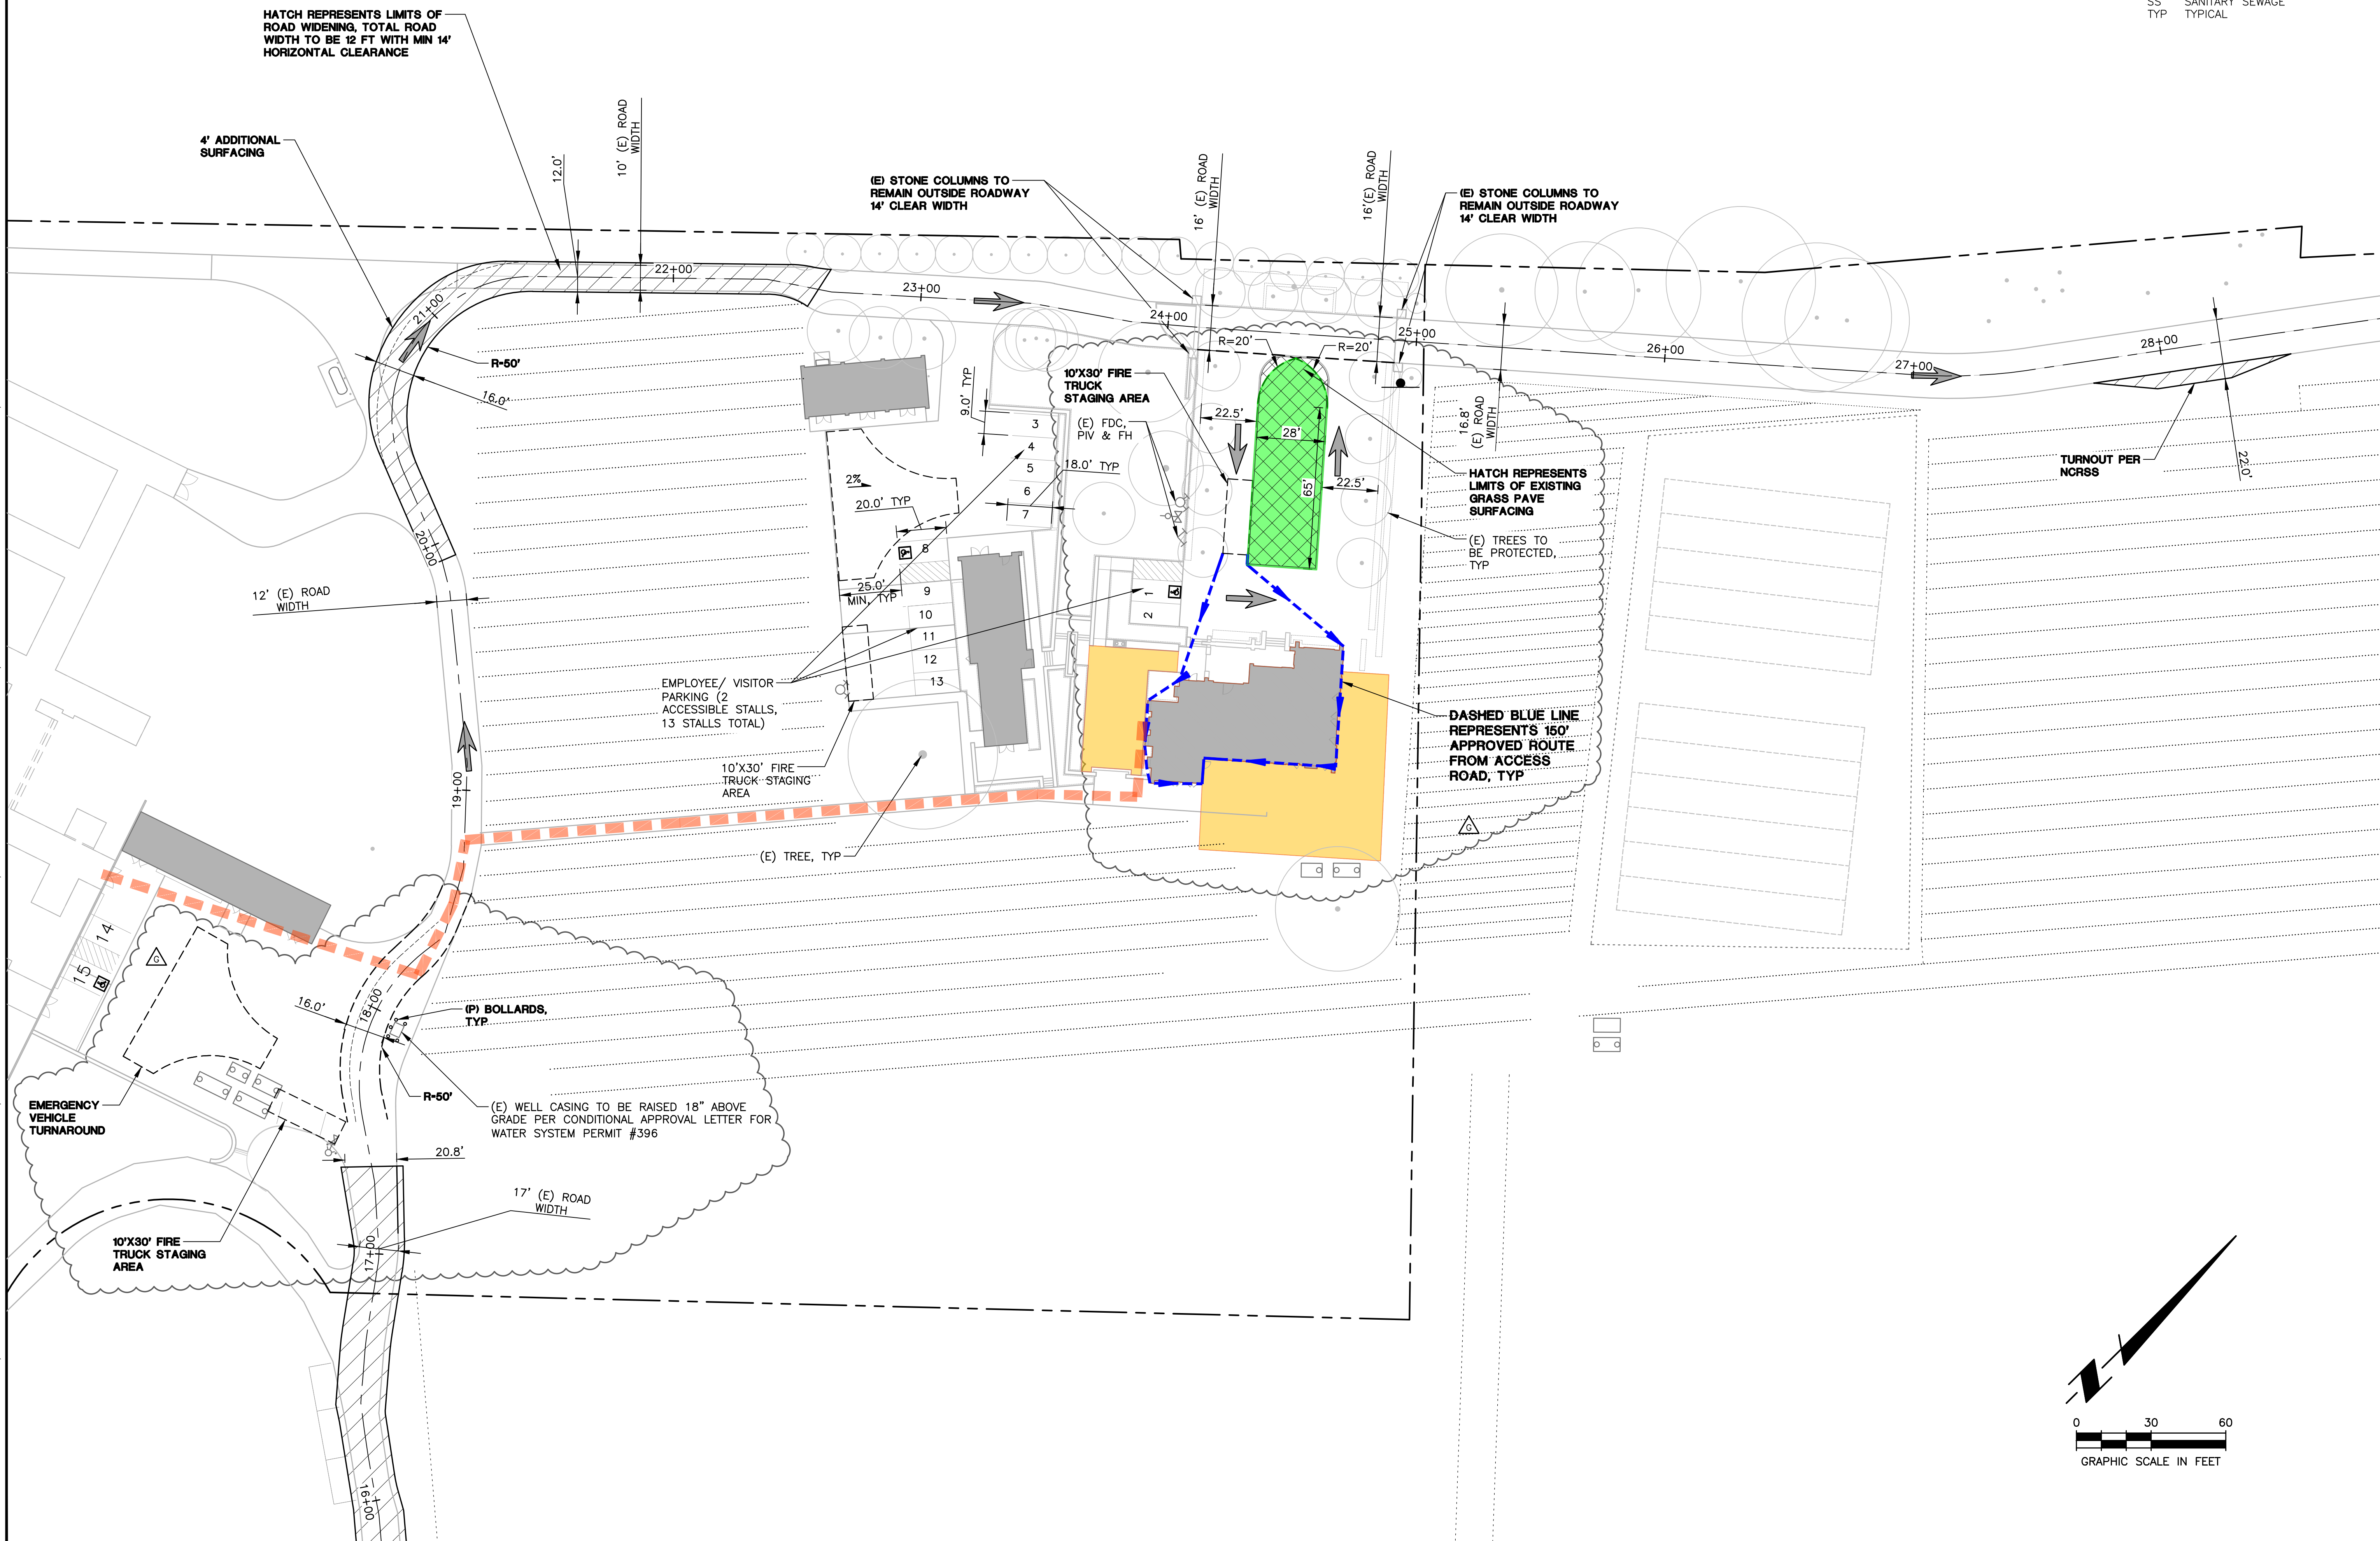

B	2019-01-29 PERMIT RESUBMITTAL
C	2019-07-26 PLAN CHECK RESPONSE
D	2020-05-11 CLIENT REVIEW
E	2020-06-02 PERMIT RESUBMITTAL
F	2020-07-23 PERMIT RESUBMITTAL
G	2020-09-22 PERMIT RESUBMITTAL

DATE:	2018-06-07
JOB NO:	2018041
SCALE:	AS SHOWN
DRAWN:	TF
CHECKED:	RP
SHEET	UP2



**STAGLIN FAMILY VINEYARD
 MANLEY HOUSE**
 1570 BELLA OAKS LANE, RUTHERFORD, CA 94573

DRAWN BY	_____
CHECKED BY	_____
PROJECT NO.	07069
DATE	10.05.08
ISSUE	PRE-APPLICATION MEETING
10.05.08	BUILDING PERMIT SET
08.22.08	CONSTRUCTION MEETING
10.14.08	FINAL REVISIONS

**MANLEY HOUSE
 FIRST FLOOR PLAN**


1/4" = 1'-0"

A2.01


- NOTES:
1. NEW WALLS SHOWN SHADED
 2. GRID LINES INDICATE F.O. (E) FINISH AT EXTERIOR WALLS BASED ON AS-BUILT DRAWINGS. E.C. VERIFY DIMENSIONS
 3. DRY STORAGE FLOOR AREA BASED ON 2 SF/1 GUEST. PER COUNTY OF NAPA, DEPT. OF ENVIRONMENTAL MANAGEMENT. EVENTS ARE LIMITED TO 45 GUESTS. 2 SF X 45 GUESTS = 90 SF REQUIRED. 26 SF DRY STORAGE PROVIDED AT MANLEY HOUSE. REMAINING 64 SF TO BE PROVIDED AT ADJACENT STORAGE BARN UNDER SEPARATE PERMIT.
 4. 2X8 TYP. EXT. WALL FRMG. U.O.N. PROVIDE FURRING, AS NEEDED, FOR 7-1/4" THICK FRMG. AT (E) EXT. WALLS.
 5. 2X6 TYP. INT. PARTITION FRMG. U.O.N. PROVIDE FURRING, AS NEEDED, FOR 5-1/2" THICK FRMG. AT (E) INT. PARTITIONS.
 6. PROVIDE ACOUSTIC WALL INSUL. IN THE FOLLOWING LOCATIONS: PARTITIONS SURROUNDING OFFICE-105 & 106, BTWN. BEVERAGE-118 & ENTRY-102, KITCHEN-117 & ENTRY-102, KITCHEN-117 & VEST-115, KITCHEN-117 & MEN-113, AND DRY. STOR.-118 & MEN-113
 7. PROVIDE VERTICAL & HORIZONTAL FIRE BLOCKING AT DOUBLE STUD WALLS, CONCEALED WALL SPACES, CONN. BTWN. HORIZONTAL & VERTICAL SPACES, STAIRWAYS, CEILING & FLOOR OPENINGS, ARCHITECTURAL TRIM AND CONCEALED SLEEPER SPACES, PER CBC 717.2.

UNDER-FLOOR VENTILATION CALCULATIONS

TOTAL CRAWL-SPACE AREA = 3,867 SF
REQ'D. VENT. AREA = 25.78 SF
(1 SF VENT/150 SF CRAWL-SPACE, PER 2007 CBC, SECTION 1203.3)
REQ'D. FREE AREA VENTILATION AREA = 3,712 SQ. IN.
TOTAL WALL VENT AREA = 3,152 SQ. IN.
3'-30" X 30" = 1,350 SQ. IN. FREE AREA
5'-24" X 24" = 1,440 SQ. IN. FREE AREA
1'-24" X 16" = 192 SQ. IN. FREE AREA
2'-17" X 10" = 170 SQ. IN. FREE AREA
TOTAL VENT WELL AREA = 864 SQ. IN.
4'-36" X 12" = 864 SQ. IN. FREE AREA
TOTAL FREE AREA VENTILATION PROVIDED = 4,016 SQ. IN.
SURPLUS VENTILATION = 304 SQ. IN.

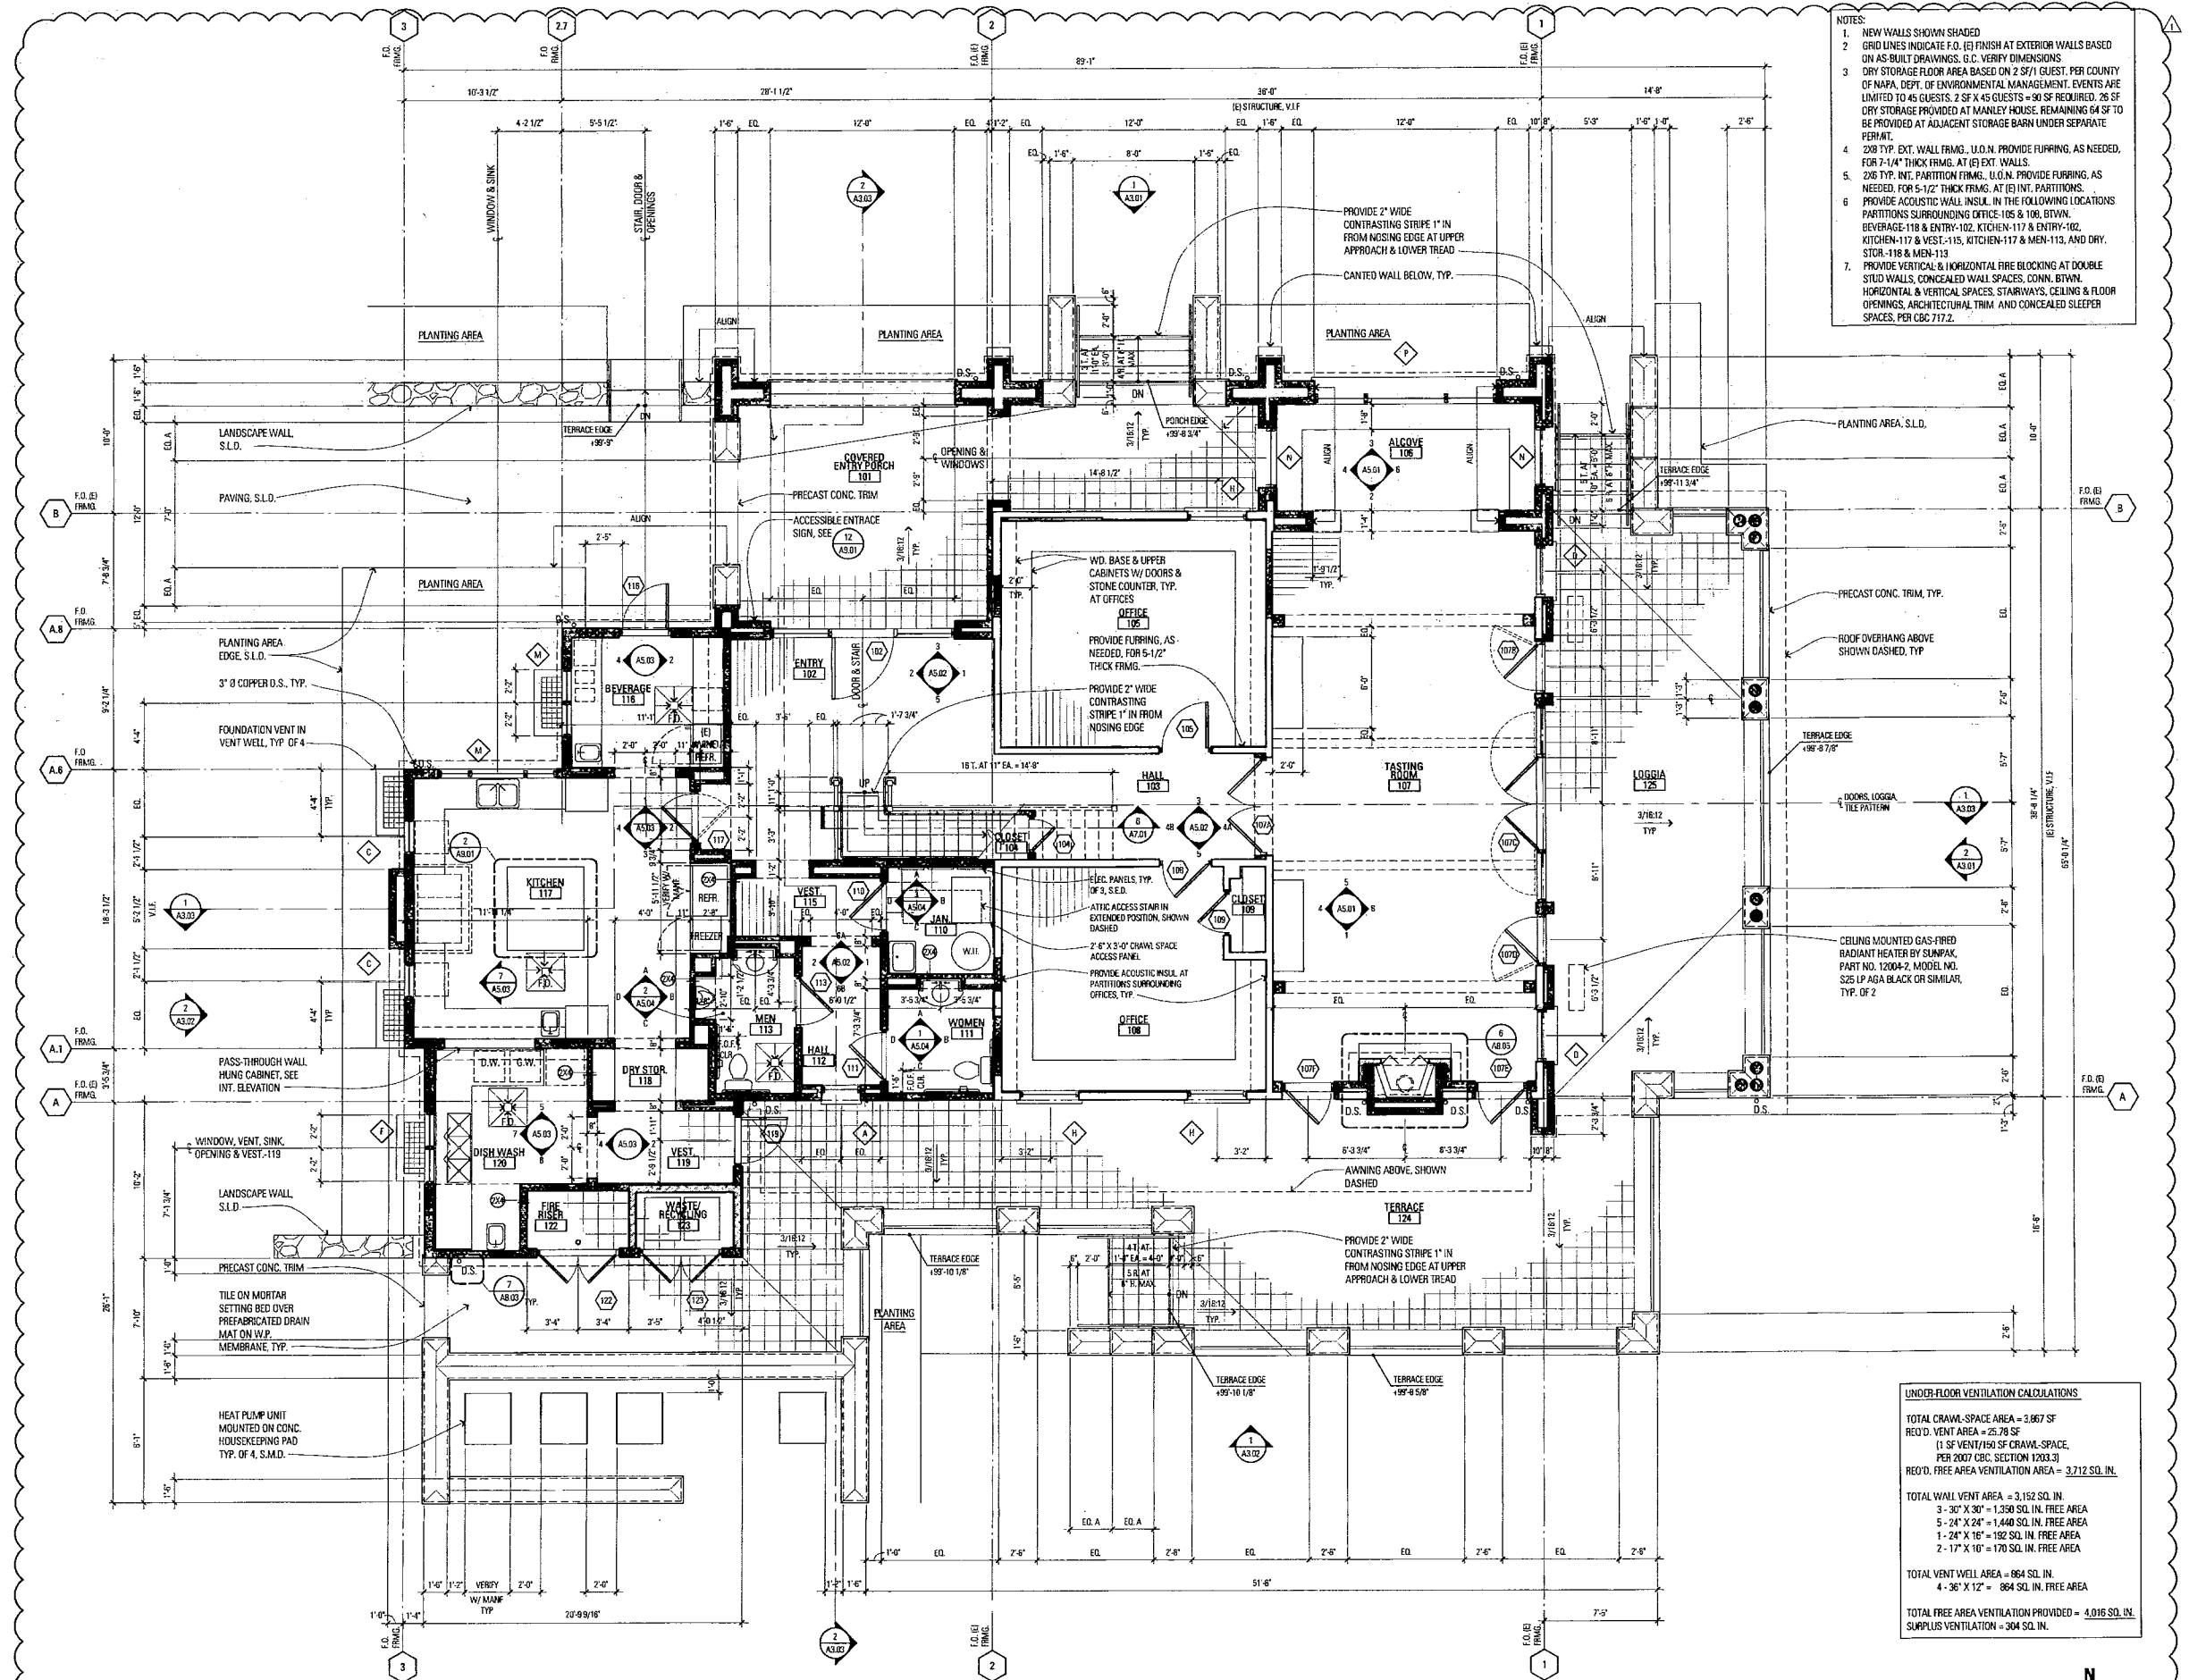

FIRST FLOOR PLAN
 1/4" = 1'-0"

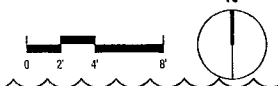


SRAFP201

COPYRIGHT © 2008 BAR ARCHITECTS
 THE MANLEY HOUSE DESIGN AND CONSTRUCTION WAS COMPLETED UNDER THE CLOSE SUPERVISION OF THE ARCHITECT. THE ARCHITECT IS NOT RESPONSIBLE FOR ANY CONSTRUCTION DEFECTS OR OMISSIONS THAT MAY OCCUR DURING THE CONSTRUCTION OF THE PROJECT. THE ARCHITECT'S LIABILITY IS LIMITED TO THE PROFESSIONAL SERVICES PROVIDED BY THE ARCHITECT. THE ARCHITECT'S LIABILITY IS LIMITED TO THE PROFESSIONAL SERVICES PROVIDED BY THE ARCHITECT. THE ARCHITECT'S LIABILITY IS LIMITED TO THE PROFESSIONAL SERVICES PROVIDED BY THE ARCHITECT.


COPYRIGHT © 2006 BAR ARCHITECTS, P.C.

FILE NAME: C:\WORK\STAGLIN\MANLEY HOUSE\SECOND FLOOR PLAN.dwg (E:\STAGLIN\MANLEY HOUSE\SECOND FLOOR PLAN.dwg) DATE: 12/14/06
 USER: J. MANLEY
 PLOT FILE NAME: C:\WORK\STAGLIN\MANLEY HOUSE\SECOND FLOOR PLAN.dwg (E:\STAGLIN\MANLEY HOUSE\SECOND FLOOR PLAN.dwg) DATE: 12/14/06
 USER: J. MANLEY
 PLOT FILE NAME: C:\WORK\STAGLIN\MANLEY HOUSE\SECOND FLOOR PLAN.dwg (E:\STAGLIN\MANLEY HOUSE\SECOND FLOOR PLAN.dwg) DATE: 12/14/06
 USER: J. MANLEY

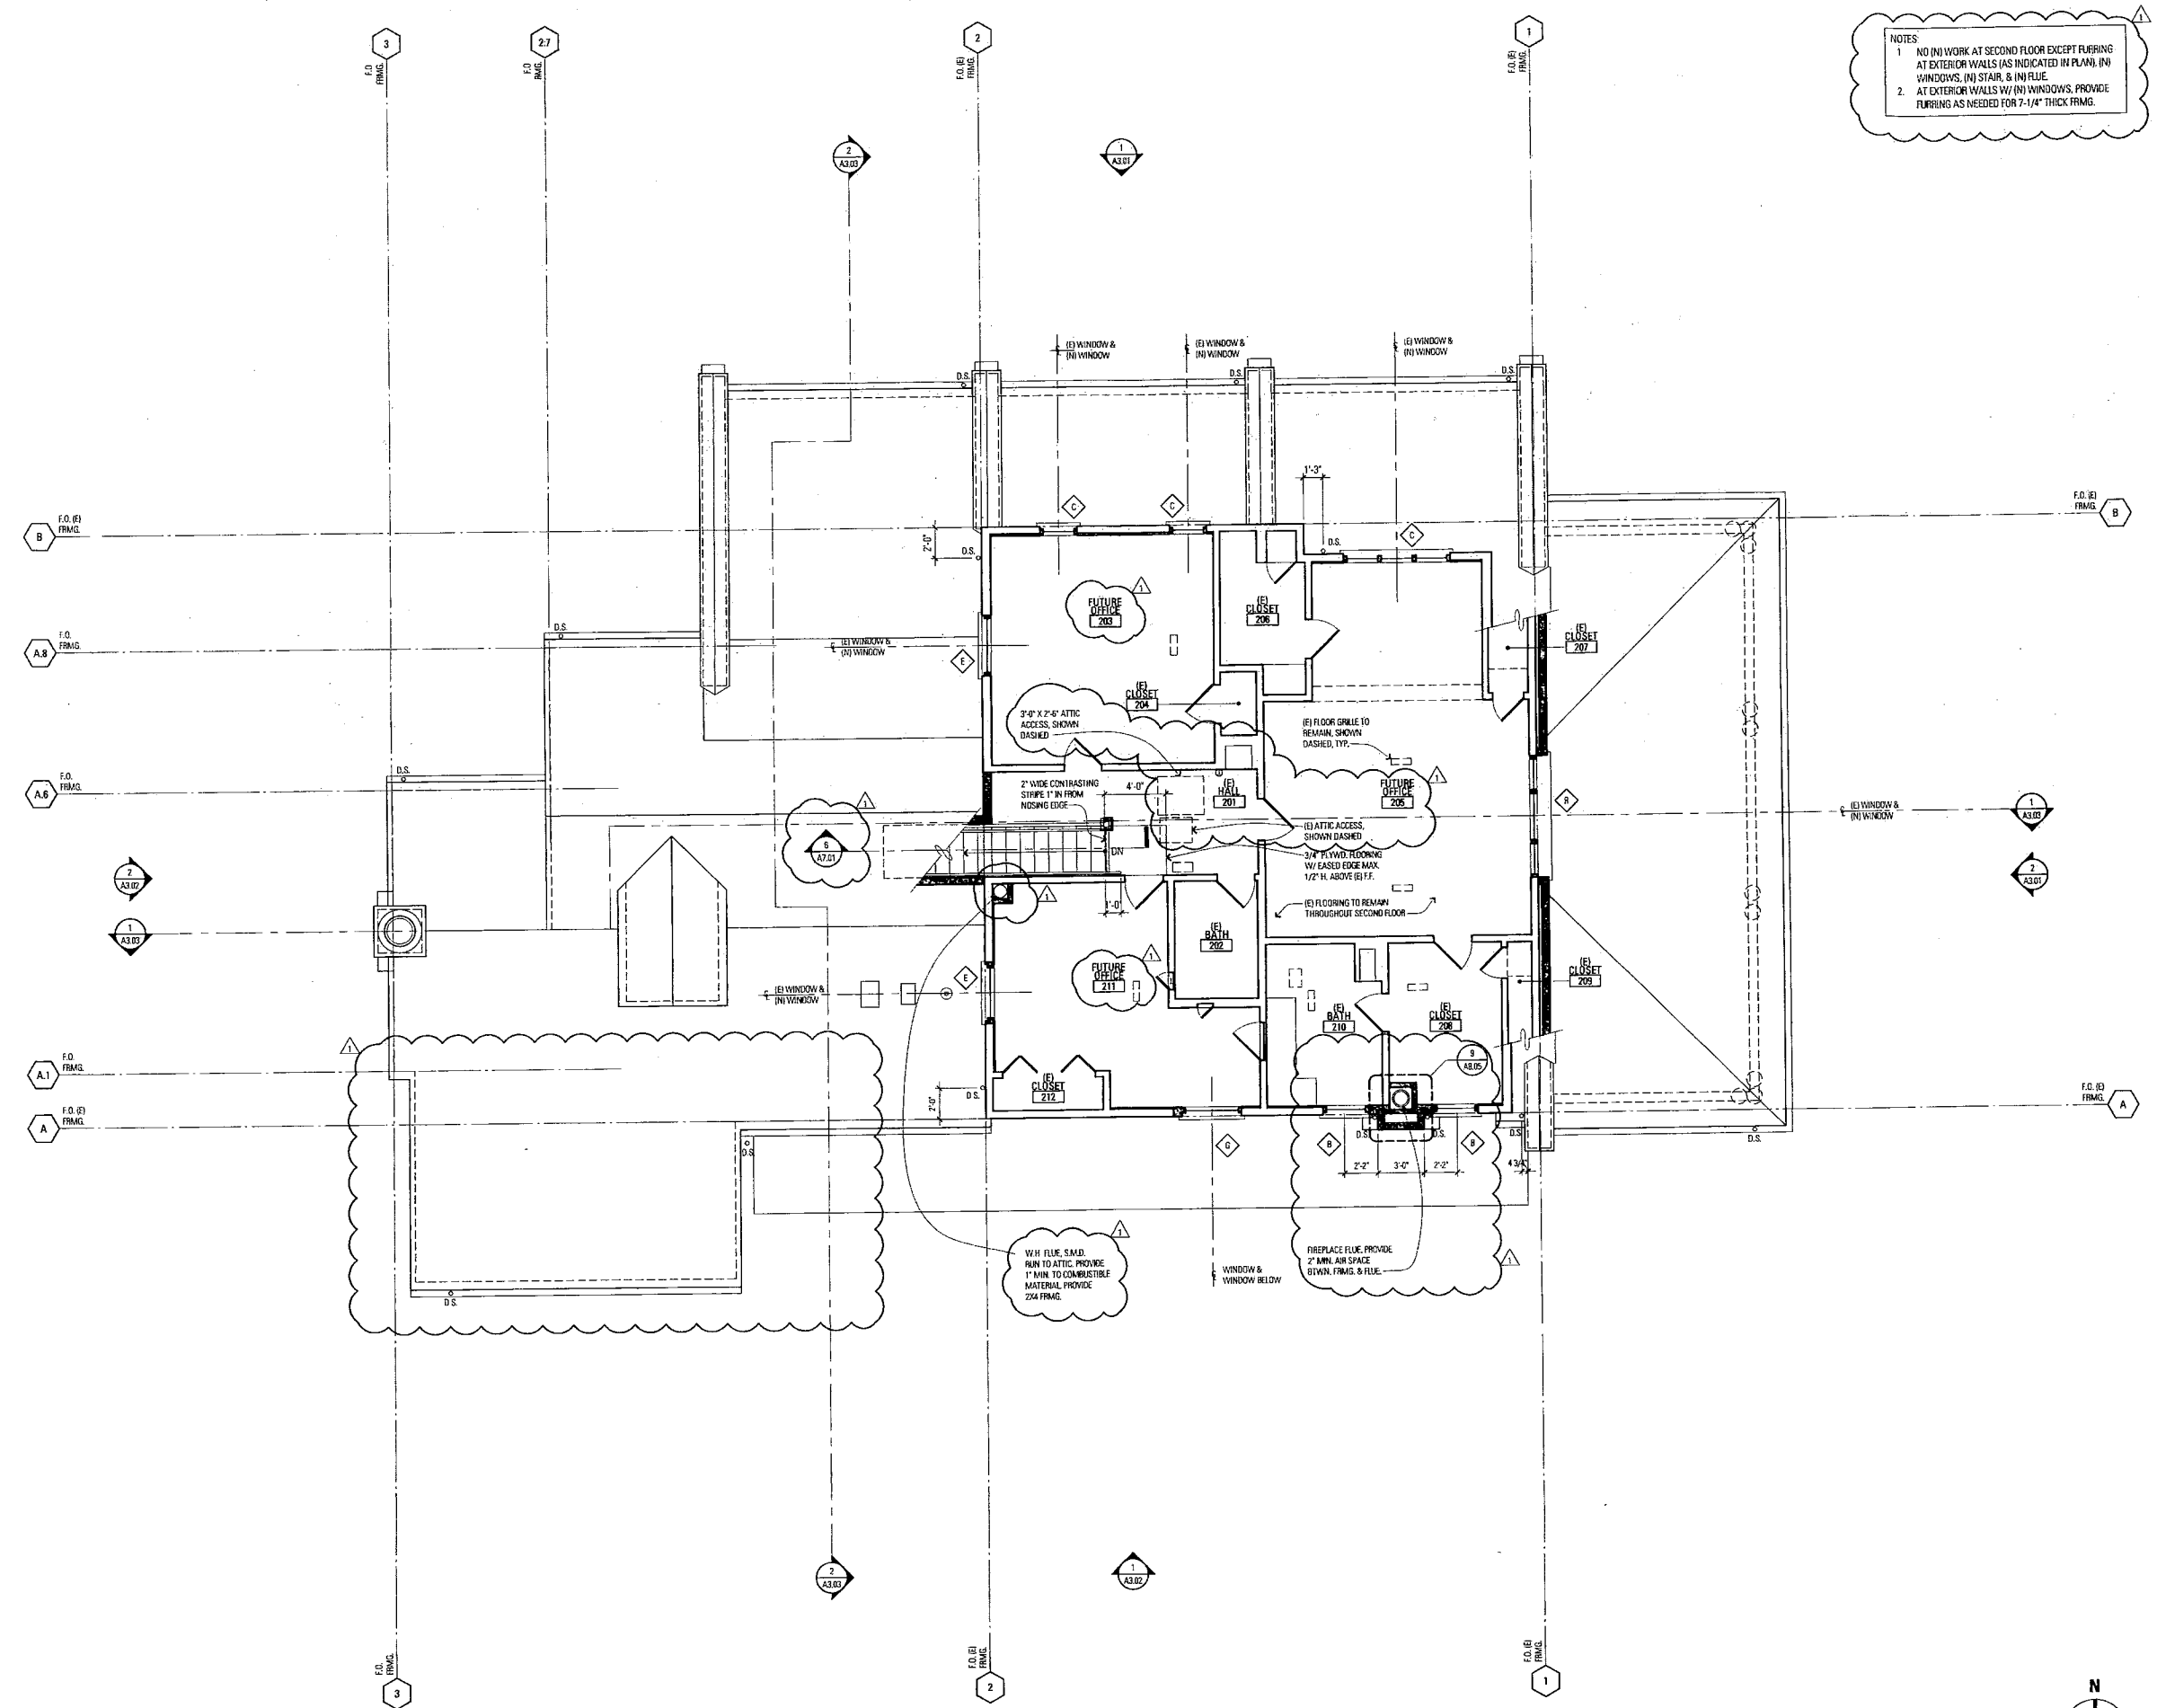

NOTES:
 1. NO (N) WORK AT SECOND FLOOR EXCEPT FLUORING AT EXTERIOR WALLS (AS INDICATED IN PLAN), (N) WINDOWS, (N) STAIR, & (N) FLUE.
 2. AT EXTERIOR WALLS W/ (N) WINDOWS, PROVIDE FLUORING AS NEEDED FOR 7-1/4\"/>

1 SECOND FLOOR PLAN
 A2.02 1/4"=1'-0"

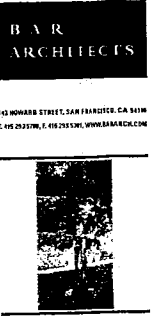

STAGLIN FAMILY VINEYARD
MANLEY HOUSE
 1570 BELLA OAKS LANE, RUTHERFORD, CA 94573

DESIGN BY: _____
 CHECKED BY: _____
 PROJECT NO: 0726
 DATE: 02/06
 ISSUE: PRELIMINARY MEETING
 06/06/06 BUILDING PERMIT SET
 10/14/06 PERMIT RESUBMITTAL

MAIN HOUSE
 SECOND FLOOR PLAN

1/4"=1'-0"

A2.02



**STAGLIN FAMILY VINEYARD
 CASE GOODS STORAGE BUILDING**
 1570 BELLA OAKS LANE, RUTHERFORD, CA 94573

DRAWN BY: _____
 CHECKED BY: _____
 PROJECT NO: 27068
 DATE: 11/25/08
 ISSUE: SCHEMATIC DESIGN
 04/24/09 BUILDING PERMIT
 06/18/09 PERMIT RESUBMITTAL



CASE GOODS STORAGE BUILDING
 FLOOR PLAN & ROOF PLAN

1/4"=1'-0"

ATTIC VENTILATION CALCULATIONS, 2007 CBC, CHAPTER 12, SECTION 1203.2

ZONE	AREA TO BE VENTILED	VENT AREA REQ'D		VENT AREA PROVIDED		TOTAL
		7/150	1/300	SAVE LOWERS**	CUPOLA UPPER**	
A	1,000 S.F.	960 SQ. IN.	480 SQ. IN.	880 SQ. IN.	598 SQ. IN.	1,706 SQ. IN.

** NET FREE VENT AREA AT EAVE = 10 SQ. IN. PER LINEAR FOOT OF EAVE
 ** NET FREE VENT AREA AT CUPOLA = WALL Louvers of HIGH X 3'-6" LONG WITH 40% FREE AREA = 151 SQ. IN. X 6 LOUVERS = 906 SQ. IN.

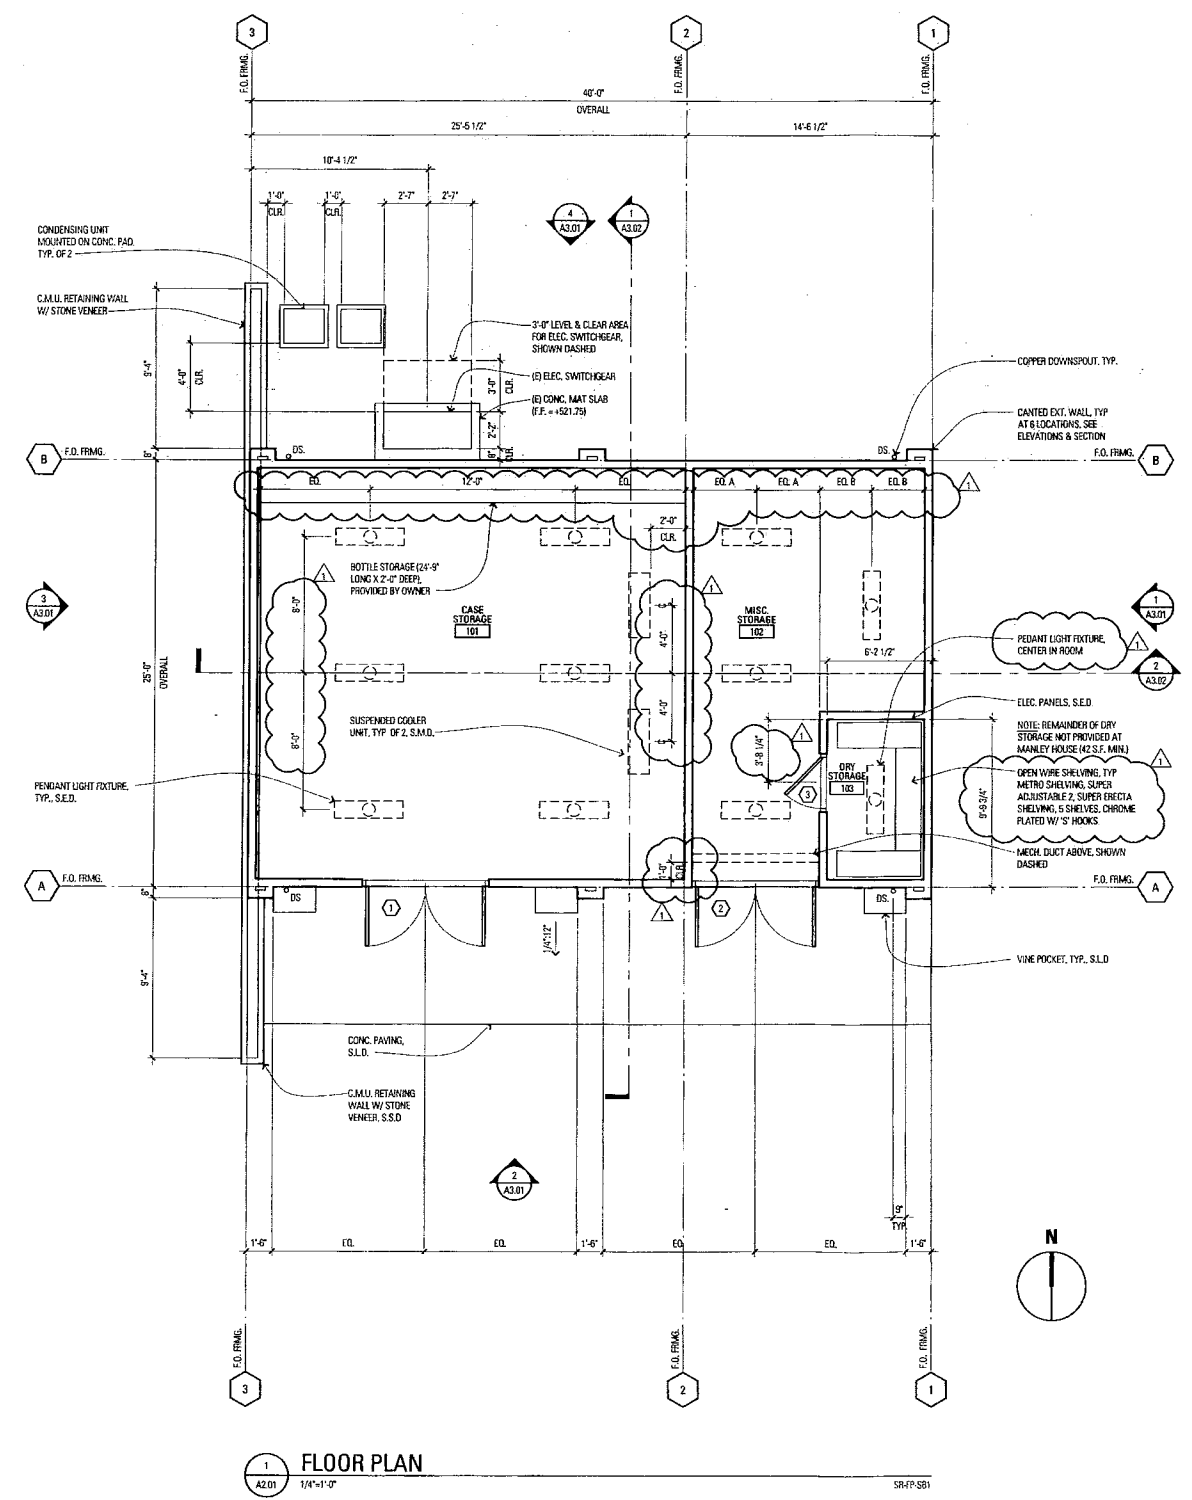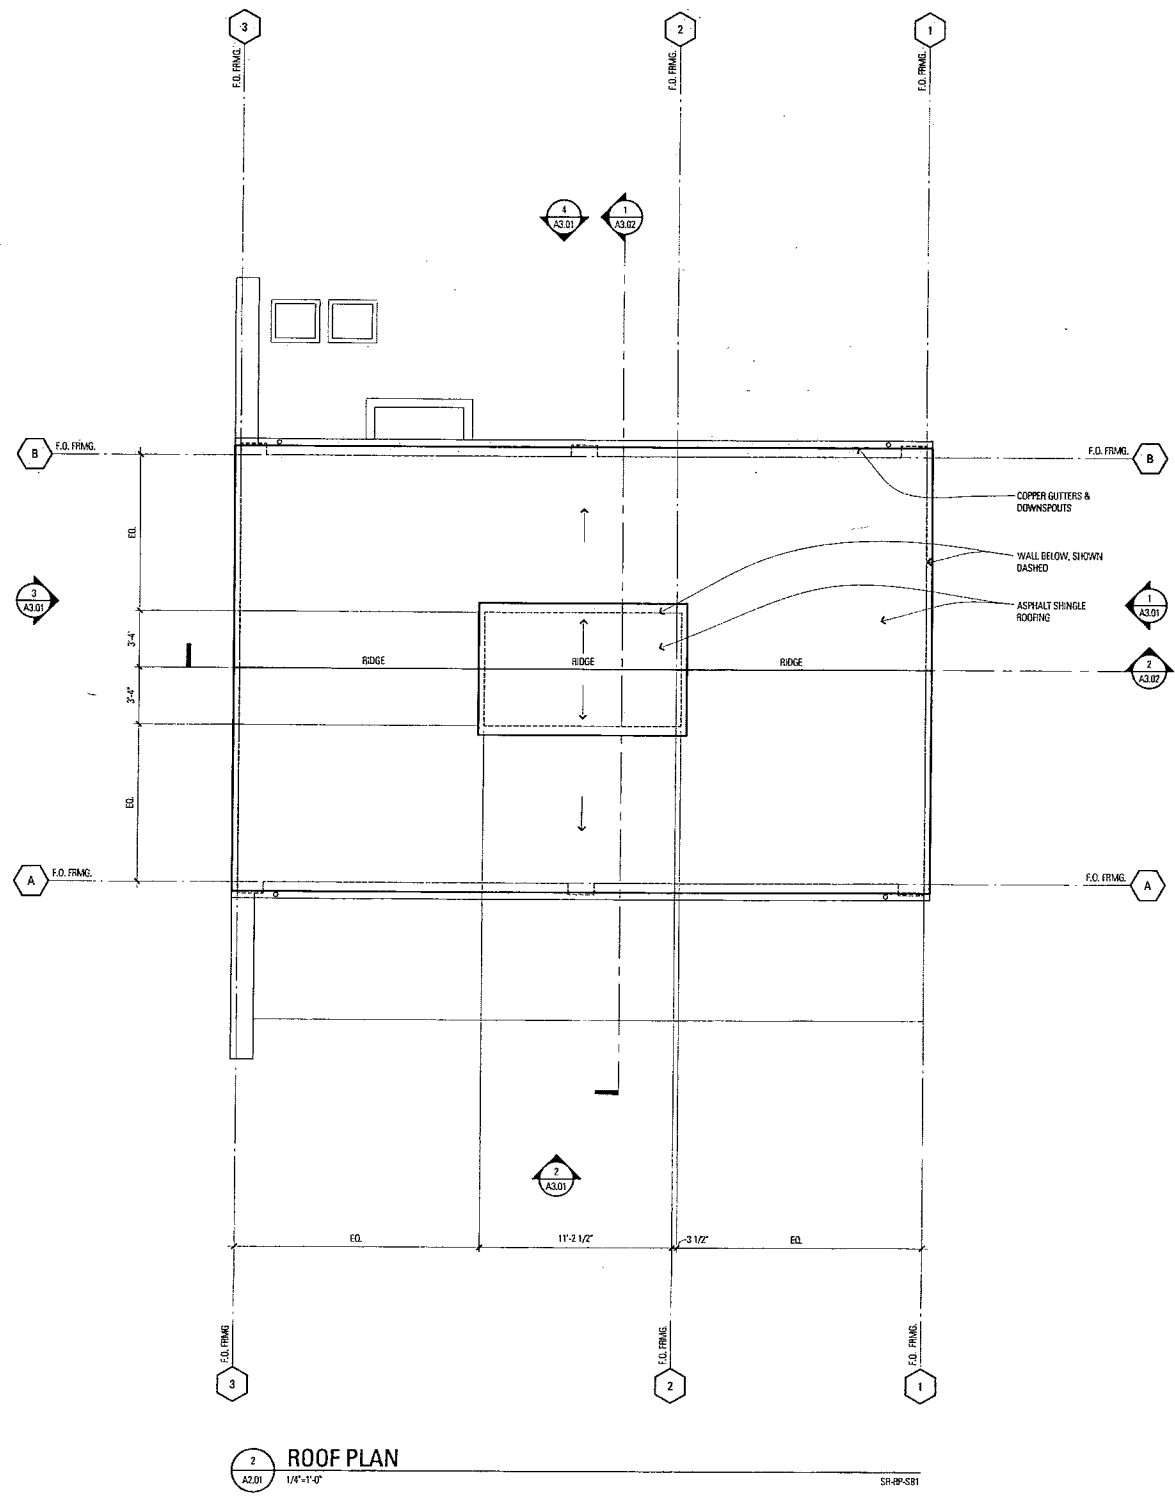

THE WORK IS TO BE PERFORMED IN ACCORDANCE WITH THE 2007 CALIFORNIA BUILDING CODE, AS AMENDED, AND THE 2007 CALIFORNIA MECHANICAL CODE, AS AMENDED. THE CONTRACTOR SHALL BE RESPONSIBLE FOR OBTAINING ALL NECESSARY PERMITS AND FOR COMPLYING WITH ALL APPLICABLE REGULATIONS AND ORDINANCES. THE ARCHITECT'S RESPONSIBILITY IS LIMITED TO THE DESIGN AND CONSTRUCTION OF THE BUILDING AS SHOWN ON THESE PLANS. THE ARCHITECT DOES NOT WARRANT THE ACCURACY OF ANY INFORMATION OR DATA PROVIDED BY OTHERS. THE ARCHITECT SHALL NOT BE RESPONSIBLE FOR ANY CONSTRUCTION DEFECTS OR FOR ANY DAMAGE TO PERSONS OR PROPERTY. THE ARCHITECT SHALL NOT BE RESPONSIBLE FOR ANY DELAYS OR FOR ANY COST INCREASES DUE TO CHANGES IN MATERIALS OR LABOR COSTS. THE ARCHITECT SHALL NOT BE RESPONSIBLE FOR ANY CONSTRUCTION DEFECTS OR FOR ANY DAMAGE TO PERSONS OR PROPERTY. THE ARCHITECT SHALL NOT BE RESPONSIBLE FOR ANY DELAYS OR FOR ANY COST INCREASES DUE TO CHANGES IN MATERIALS OR LABOR COSTS.

COPYRIGHT © 2008 BAR ARCHITECTS



**STAGLIN FAMILY VINEYARD
OFFICE CABANA**
1570 BELLA OAKS LANE, RUTHERFORD, CA 94573

DRAWN BY: _____
CHECKED BY: _____
PROJECT NO: 12000
DATE: 10.01.08
03.26.08 PERMIT SET
06.26.08 PERMIT RESUBMITAL


OFFICE CABANA
FLOOR PLAN &
ROOF PLAN

1/4" = 1'-0"


ATTIC VENTILATION CALCULATIONS						
AREA	AREA TO BE VENTED	REQ'D. VENT AREA	VENT AREA PROVIDED	AREA PROVIDED	FREE AREA	RESULT
1	64 SF	1/150 = 0.67 SF	1/200 = 0.32 SF	EAVE VENTS 1.310 SF	0.068 SF	0.774 SF > 0.212 SF. THIS IS OKAY.
				GABLE VENT 1.448 SF	0.855 SF	
				TOTAL	0.923 SF	

NOTES:
1. NATURAL VENTILATION PROVIDED FOR ATTIC SPACE OVER PORCH.
2. MECHANICAL VENTILATION PROVIDED FOR ATTIC SPACE OVER VESTIBULE/INSEX ACCESSIBLE RESTROOM. MECHANICAL DESIGN & CALCULATIONS ASSUME EQUIPMENT AND DUCTS ARE WITHIN CONDITIONED ENVELOPE.
3. REMAINING ROOF AREAS DO NOT HAVE ENCLOSED ATTIC OR ENCLOSED RAFTER SPACE. ROOF/CEILING ASSEMBLY IS RIGID ROOF INSULATION COMPOSITE PANEL APPLIED DIRECTLY TO STRUCTURAL SHEATHING. 2007 CBC, SECTION 103.2 ATTIC SPACE DOES NOT APPLY TO THESE AREAS.

- GENERAL NOTES**
- 5/8" INSULATION AT ALL EXTERIOR WALLS.
 - R-5 INSULATION AT THE ROOF.
 - ALL WALLS ARE 20S CONSTRUCTION. ALL WALLS ARE FINISHED TO 20S WALL.
 - AREA ENCLOSED BY WALLS IS CONDITIONED SPACE EXCEPT FOR WATER HEATER CLOSET.
- SHEET NOTES**
- WOOD & PLASTICS
- 8.1 1/4" WIDE WOOD CAP ON PARTIAL HT. WALL
- THERMAL & MOISTURE PROTECTION
- 7.1 INTERIOR WALL W/ MIN. R-13 WALL INSULATION
- OPENINGS
- 8.1 IN WINDOW IN EXIST. OPENING
 - 8.2 TEMPERED GLAZING
- FINISHES
- 8.1 2" SOL. CORE FLOOR TILE
 - 8.2 1/2" SOL. CERAMIC TILE
 - 8.3 CARPET
- SPECIALTIES
- 10.1 CLOSET ROD W/ SHLF ABOVE
- EQUIPMENT
- 11.1 ADA-COMPLIANT UNDERCOUNTER REFRIGERATOR W/ CUSTOM PANEL TO MATCH CABINETS
 - 11.2 ACCESSIBLE SINK W/ LEVER FAUCET
- FURNISHINGS
- 12.1 PAINT-GRADE MFC CABINETS & BUILT-INS W/ 1" V-GROOVE PANELING
 - 12.2 FINISH-GRADE PLYWOOD CABINETS & BUILT-INS. CLEAR FINISH

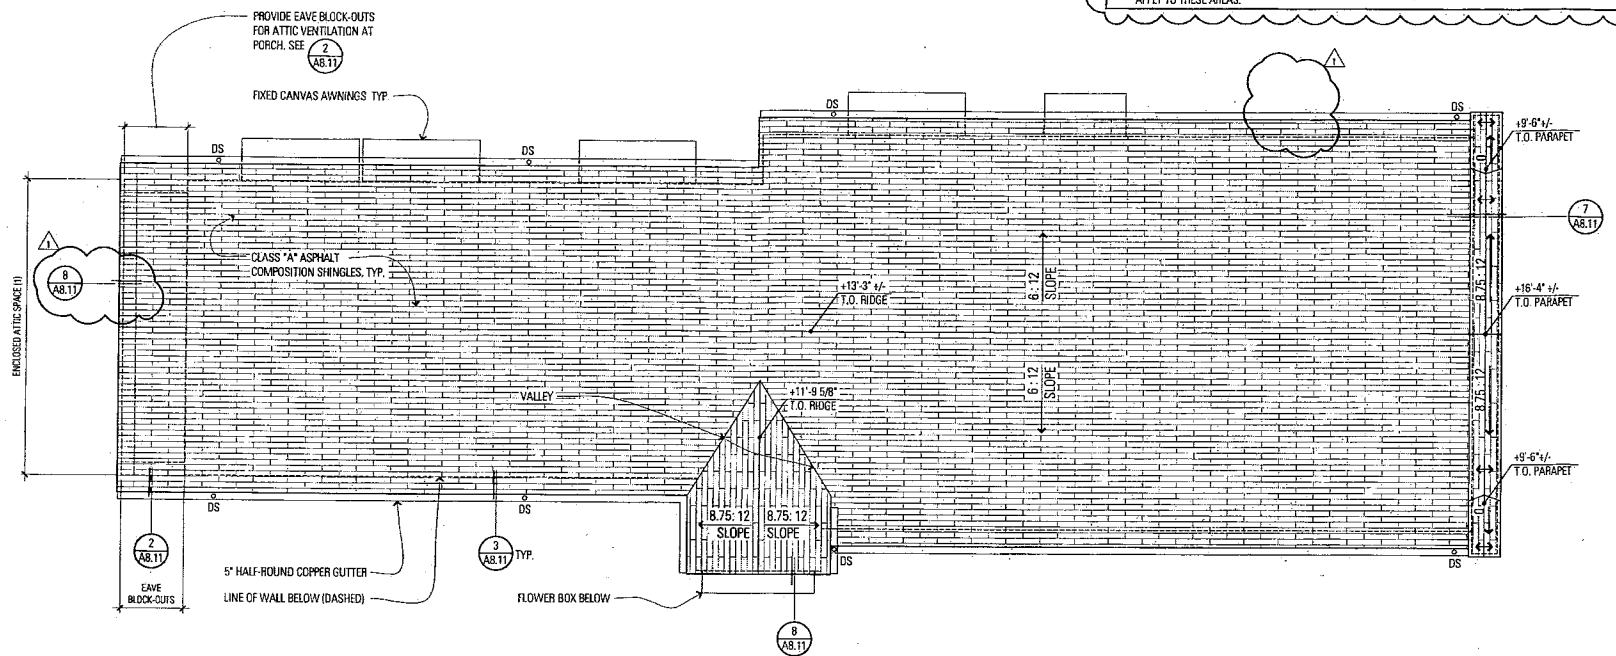

2 ROOF PLAN: OFFICE CABANA
1/4" = 1'-0"

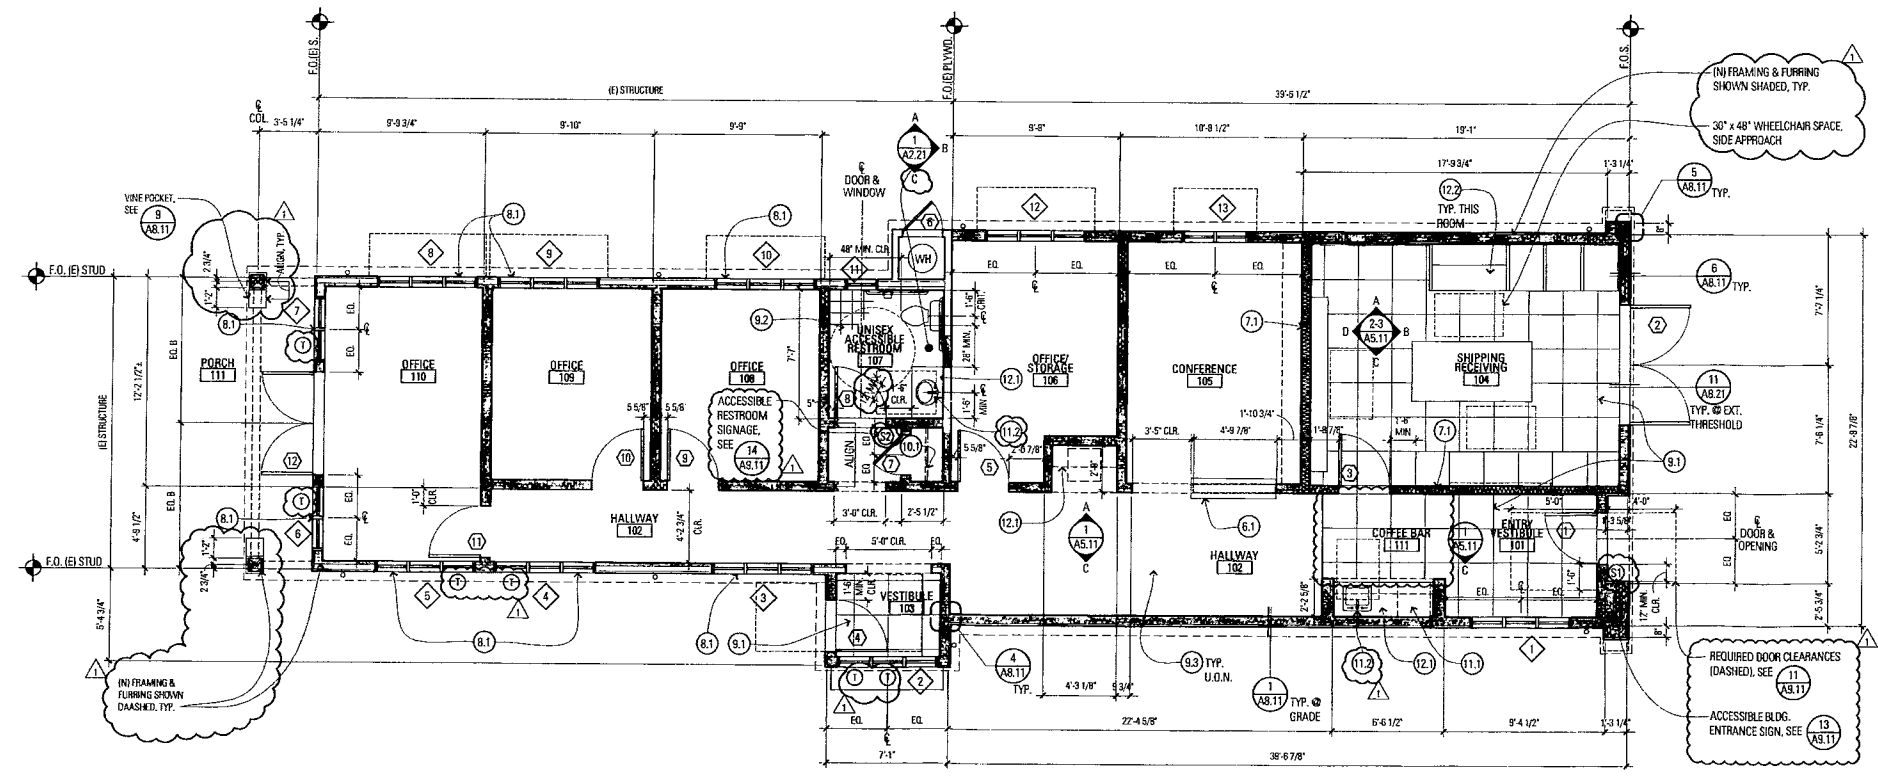

1 FLOOR PLAN: OFFICE CABANA (1,469 SF)
1/4" = 1'-0"

FILE NAME: Z:\PROJECTS\STAGLIN FAMILY VINEYARD\OFFICE CABANA\DWG\1111.DWG | TAB: 0200.DWG | June 27 - Friday 2008 - 5:42pm | Printed by: RSMONSON | Plot Setting: Full (A4)
XREF FILE NAME: 3SR\FLOOR PLAN TAGS - 3SR\F211 - 3SR\F212 - 3SR\F213 - 3SR\F999 - 3SR\F1000