
""

Graphics


NAPA COUNTY LAND USE PLAN 2008 - 2030




LEGEND

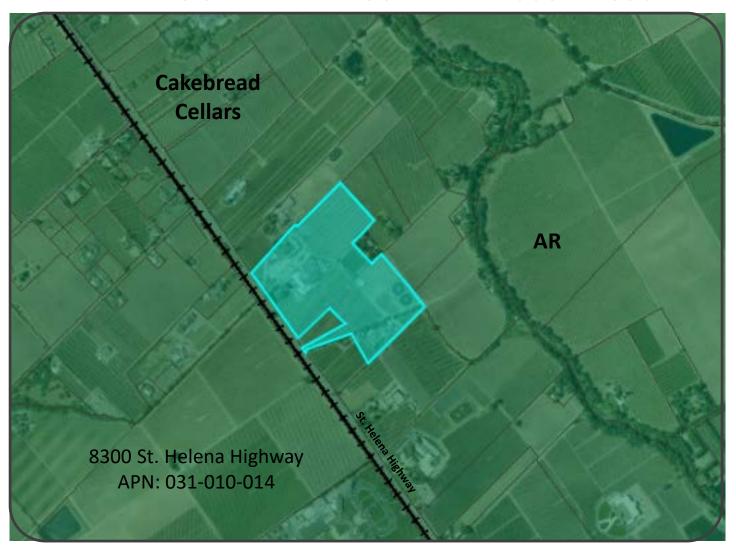


URBANIZED OR NON-AGRICULTURAL TRANSPORTATION Study Area Mineral Resource Cities Limited Access Highway Urban Residential* American Canyon ULL Rural Residential* City of Napa RUL Industrial Landfill - General Plan Public-Institutional Road Napa Pipe Mixed Use Airport **OPEN SPACE** Railroad Agriculture, Watershed & Open Space Airport Clear Zone Agricultural Resource

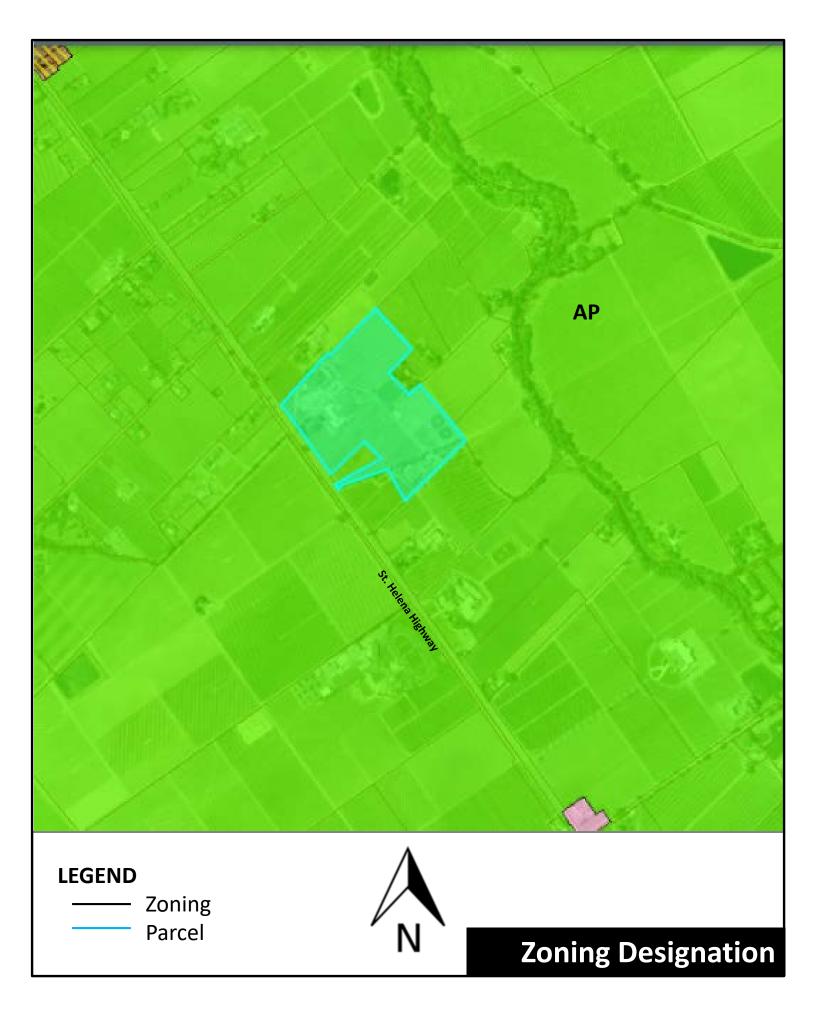




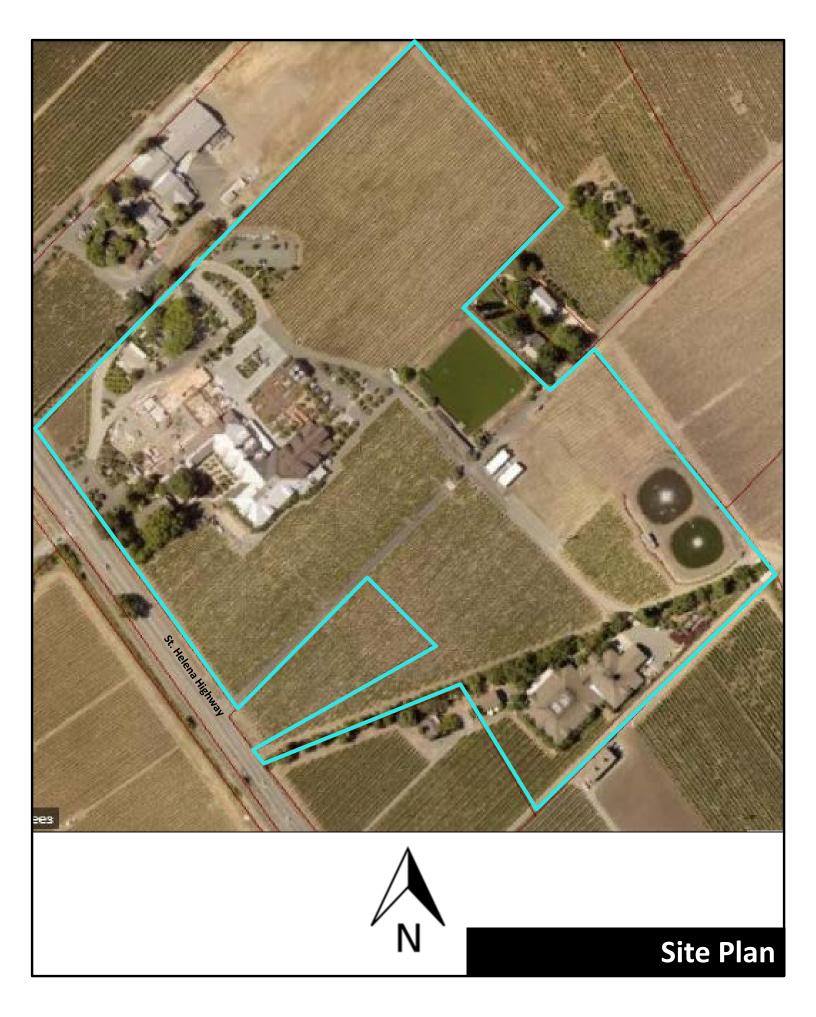

| The control of the

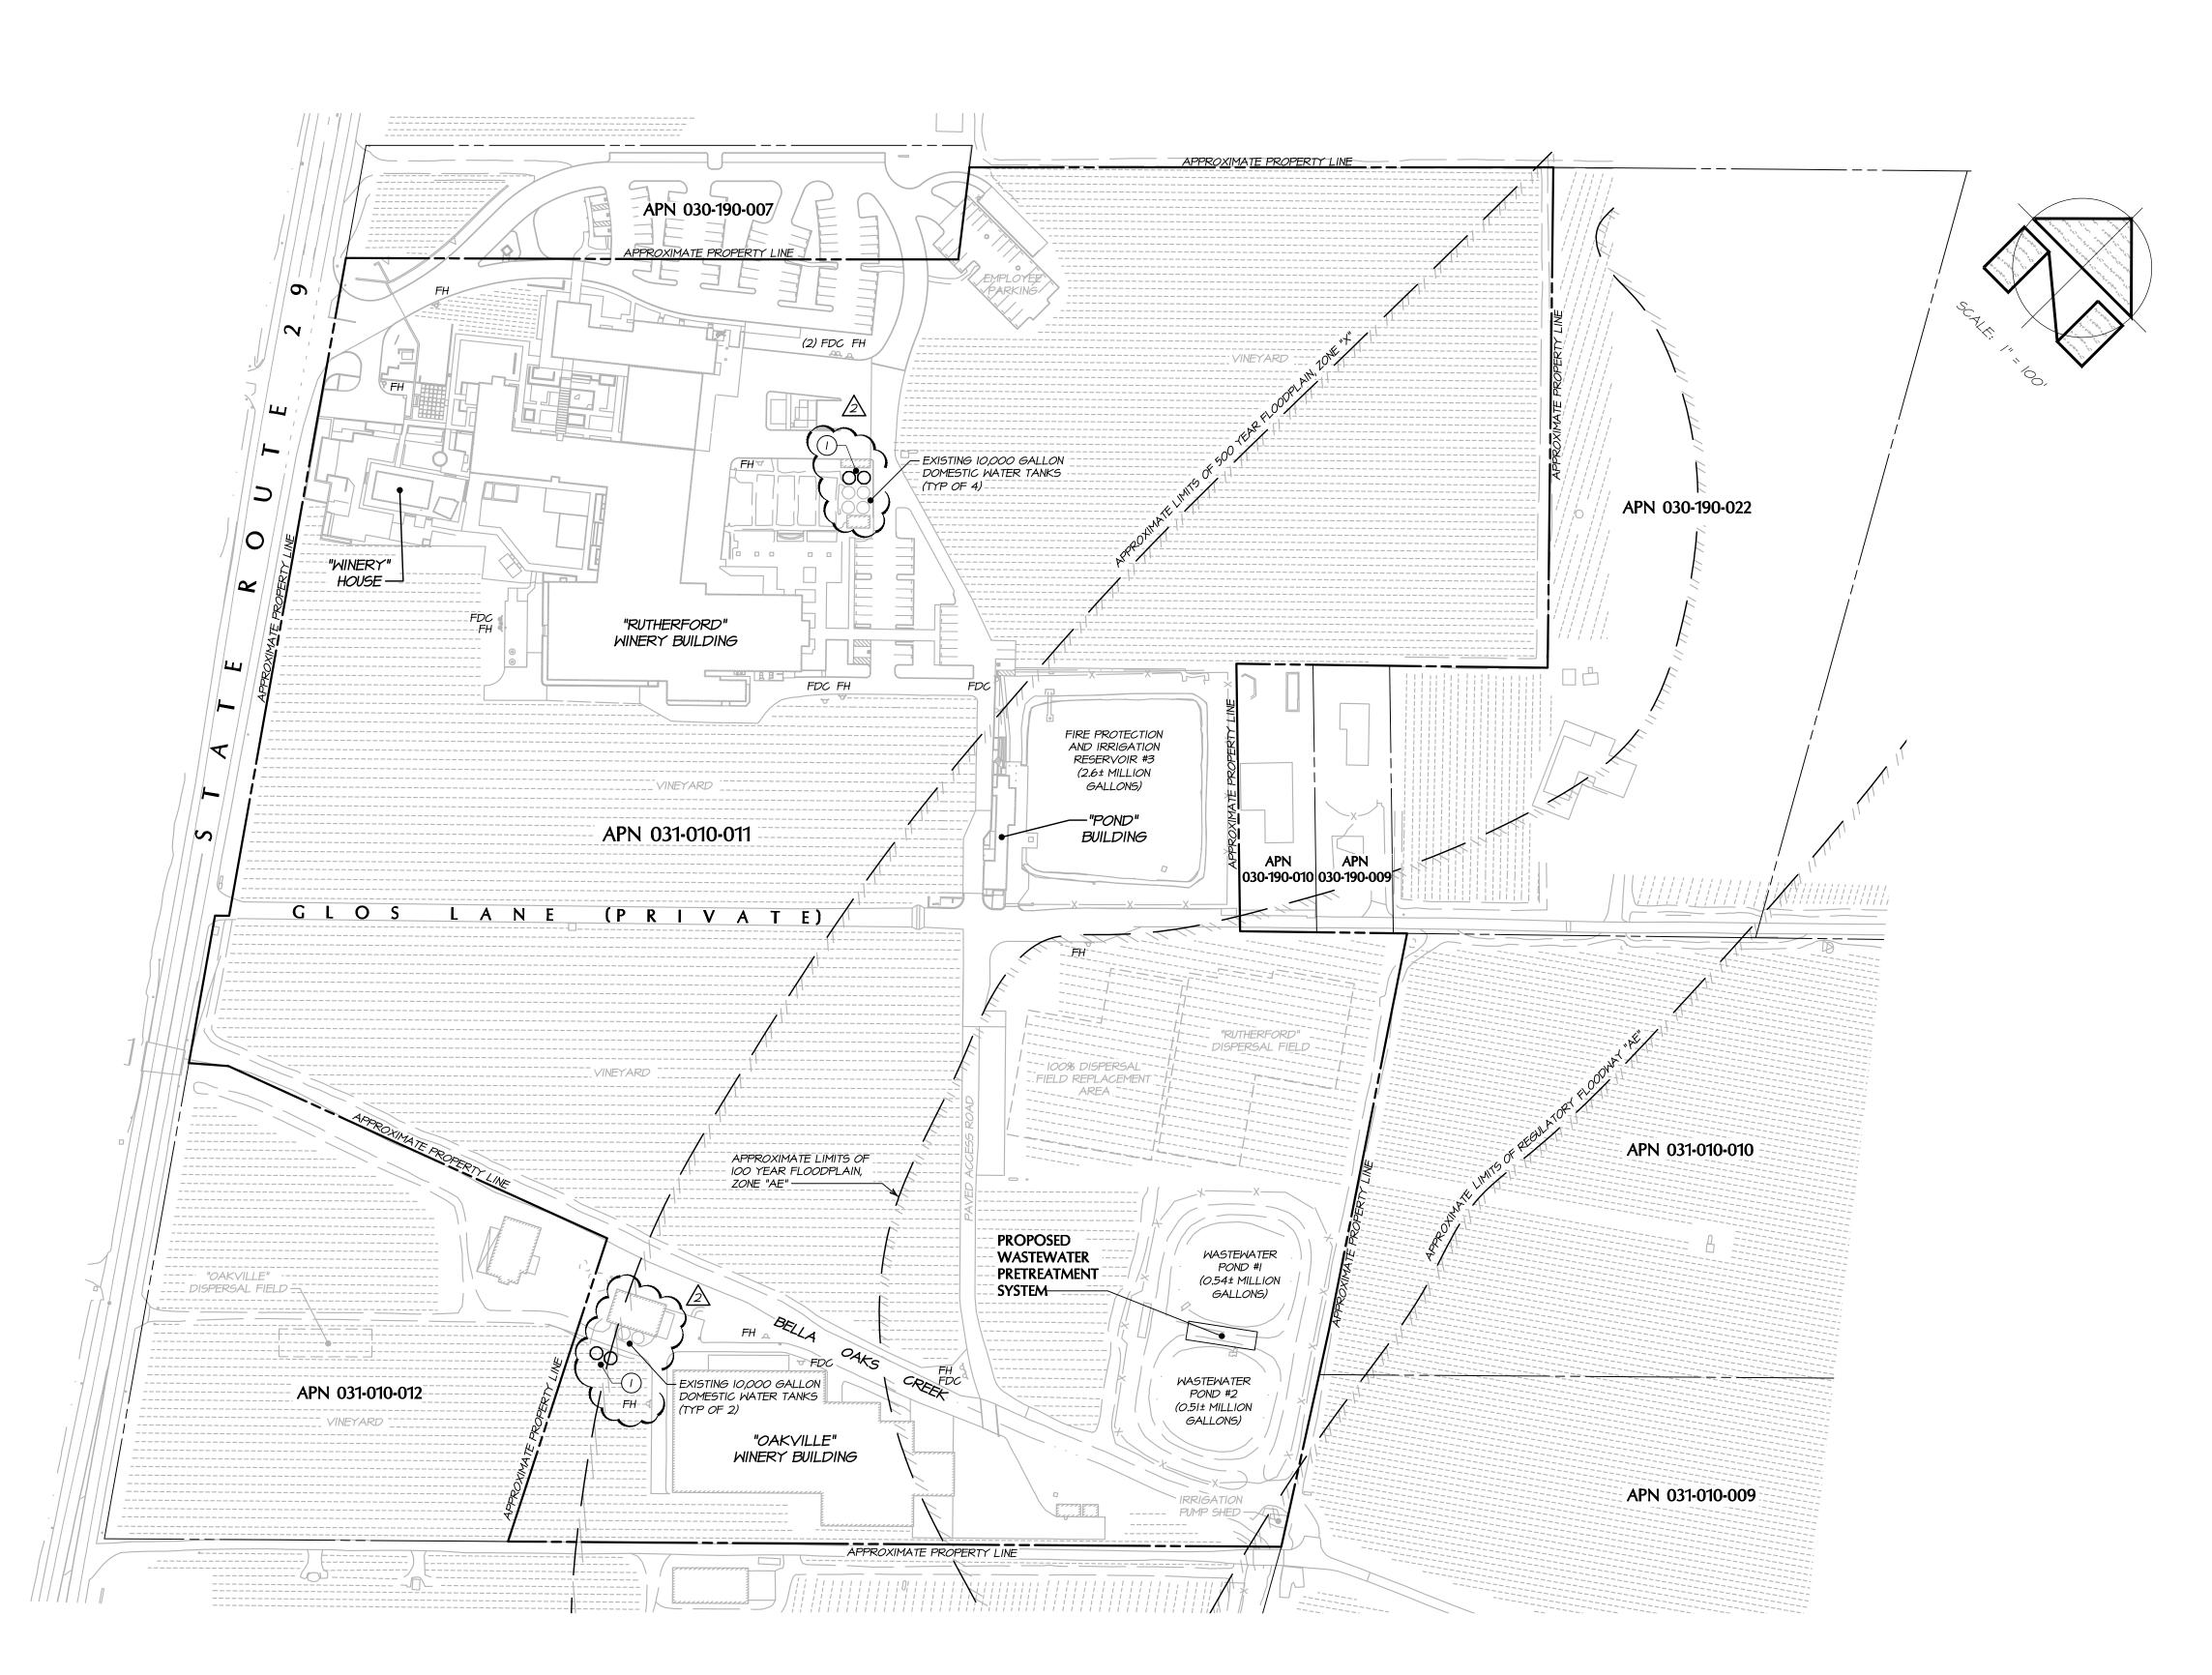

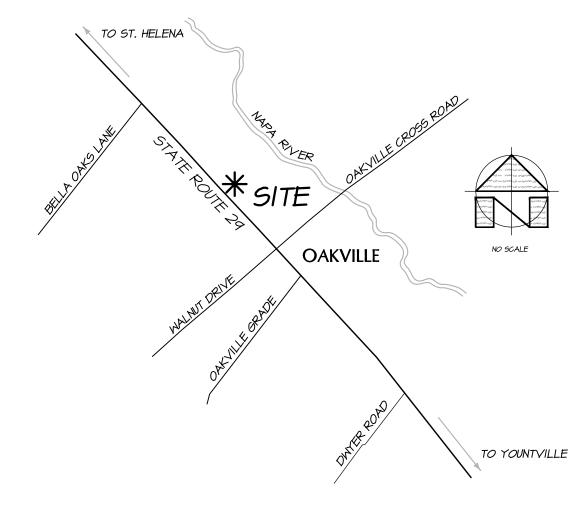

LOCATION MAP

PROJECT INFORMATION:

PROPERTY OWNER & APPLICANT: CAKEBREAD HOME RANCH, LP C/O BRUCE CAKEBREAD P.O. BOX 216 RUTHERFORD, CA 94573

PROJECT ADDRESS: 8300 ST. HELENA HIGHWAY RUTHERFORD, CA 94573

ASSESSOR'S PARCEL NUMBER: 031-010-011

PARCEL SIZE: *36.39± ACRES*

PARCEL ZONING:

SHEET INDEX:

OVERALL SITE PLAN SHEET UP2 LOT LINE ADJUSTMENT EXHIBIT PHOTOGRAPHIC DOCUMENTATION SHEET UP3 EXISTING CONDITIONS - NORTH SHEET UP5 EXISTING CONDITIONS - SOUTH SHEET UP6 WINERY COVERAGE EXHIBITS SHEET UPT WINERY DEVELOPMENT AREA EXHIBITS SHEET UPS WINERY ACCESSORY TO PRODUCTION RATIO EXHIBITS

SHEET UP9 IMPERVIOUS AREA EXHIBITS

FEMA FLOOD DATA:

A PORTION OF THIS PROJECT IS LOCATED WITHIN A FLOODWAY OR FLOOD PLAIN PER FLOOD INSURANCE RATE MAP (FIRM) PANEL NO. 06055C0385E. ZONE "X" IS DETERMINED TO BE INSIDE THE 0.2% ANNUAL CHANCE FLOODPLAIN IN AN UNINCORPORATED AREA OF NAPA COUNTY.

FEMA FLOOD ZONE

(NOTE:

DOMESTIC WATER STORAGE TANKS ARE PROPOSED FOR FUTURE INSTALLATION IF AND WHEN CAKEBREAD CELLARS DETERMINES THAT ADDITIONAL DOMESTIC WATER STORAGE IS REQUIRED TO PROVIDE ADEQUATE WATER STORAGE TO ACCOMMODATE ANY FUTURE INCREASE IN



PREPARED UNDER THE DIRECTION OF

R.C.E. 84634 RICHARD PAXTON


OVERALL SITE PLAN

2 02-05-2020 NAPA COUNTY PLAN REVIEW COMMENTS, DATED 12-30-19 UPI, UP4-UP7 & UP9 KK 09-10-2019 NAPA COUNTY PLAN REVIEW COMMENTS, DATED 05-17-19 UP4-UP6 & UP9 NO. DATE DESCRIPTION SHEETS

P19-00074

ш

DATE: MARCH 2019 JOB NO: 98-62

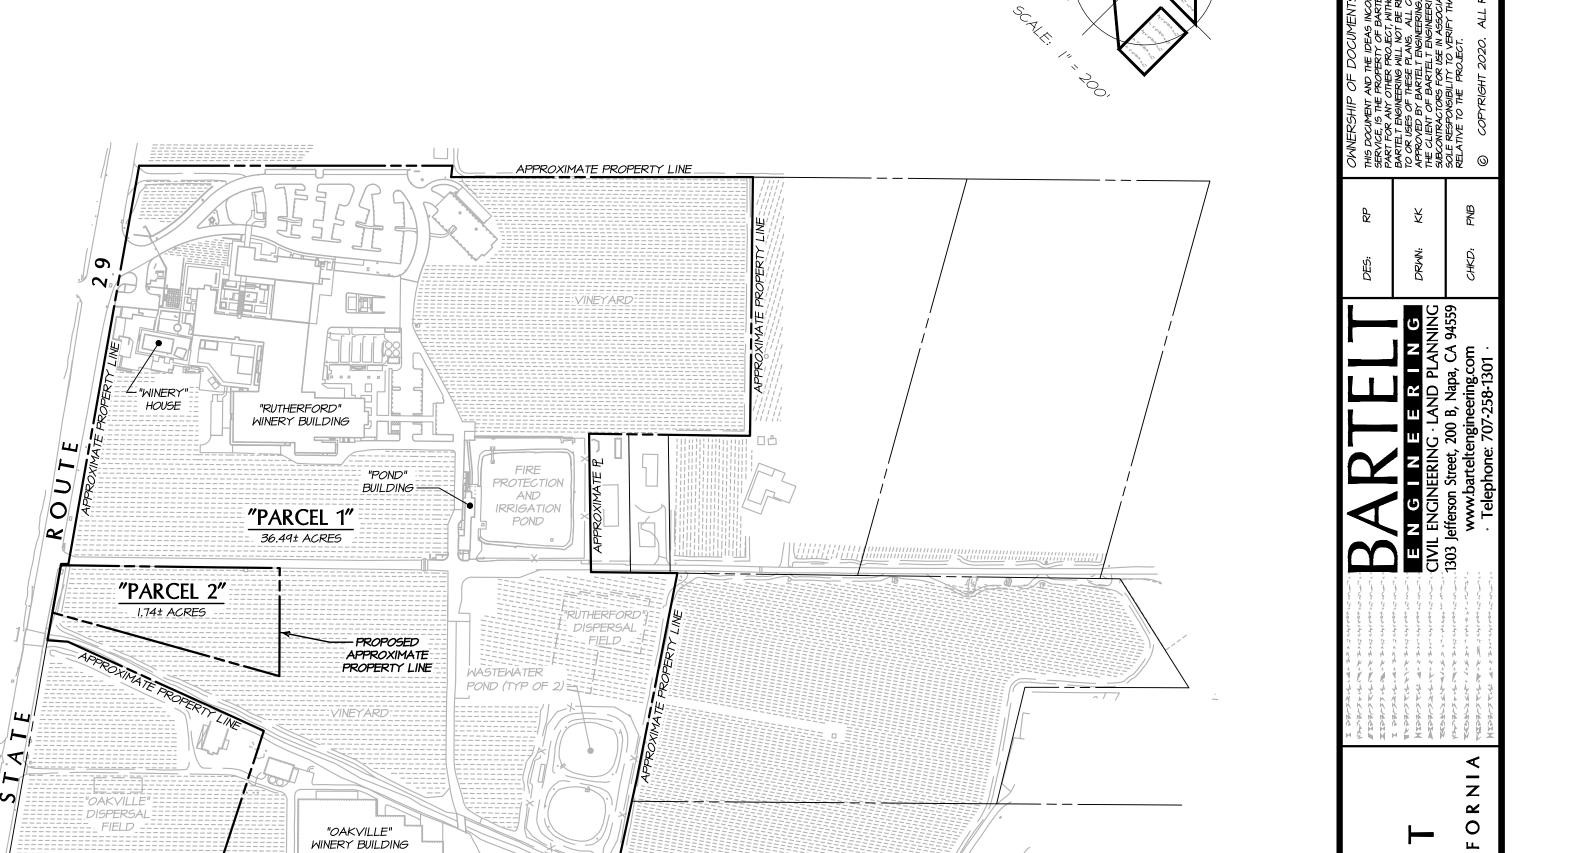

PROPOSED CONDITIONS SCALE: |" = 200'

NOTE:

SEE THE "LOT LINE ADJUSTMENT MAP OF THE LANDS OF CAKEBREAD HOME RANCH, L.P." PREPARED BY TERRA FIRMA SURVEYS, INC., DATED FEBRUARY 12, 2019, FOR FURTHER INFORMATION REGARDING THE PROPOSED LOT LINE ADJUSTMENT SHOWN HEREON.





PREPARED UNDER THE DIRECTION OF

RICHARD PAXTON R.C.E. 84634

DATE: MARCH 2019

JOB NO: 98-62

SHEET NO:

OF 9

PHOTOGRAPH 1

EASTERLY PANORAMIC VIEW OF THE PLA BOOTH,
"RUTHERFORD" WINERY BUILDING AND ENTRANCE GATE



PHOTOGRAPH 2

SOUTHWESTERLY PANORAMIC VIEW OF THE RUTHERFORD GARDEN, AND THE "RUTHERFORD" WINERY BUILDING



PHOTOGRAPH 3

NORTHERLY PANORAMIC VIEW OF THE SOUTH COURTYARD,
"WINERY" HOUSE, AND THE "RUTHERFORD" WINERY BUILDING




PHOTOGRAPH 4

SOUTHWESTERLY PANORAMIC VIEW FROM THE "POND" BUILDING
OF VINEYARD, AND THE "RUTHERFORD" WINERY BUILDING



PHOTOGRAPH 5

SOUTHWESTERLY PANORAMIC VIEW OF THE "OAKVILLE" WINERY BUILDING, VINEYARD, "RUTHERFORD" WINERY BUILDING, AND TEMPORARY TRAILERS

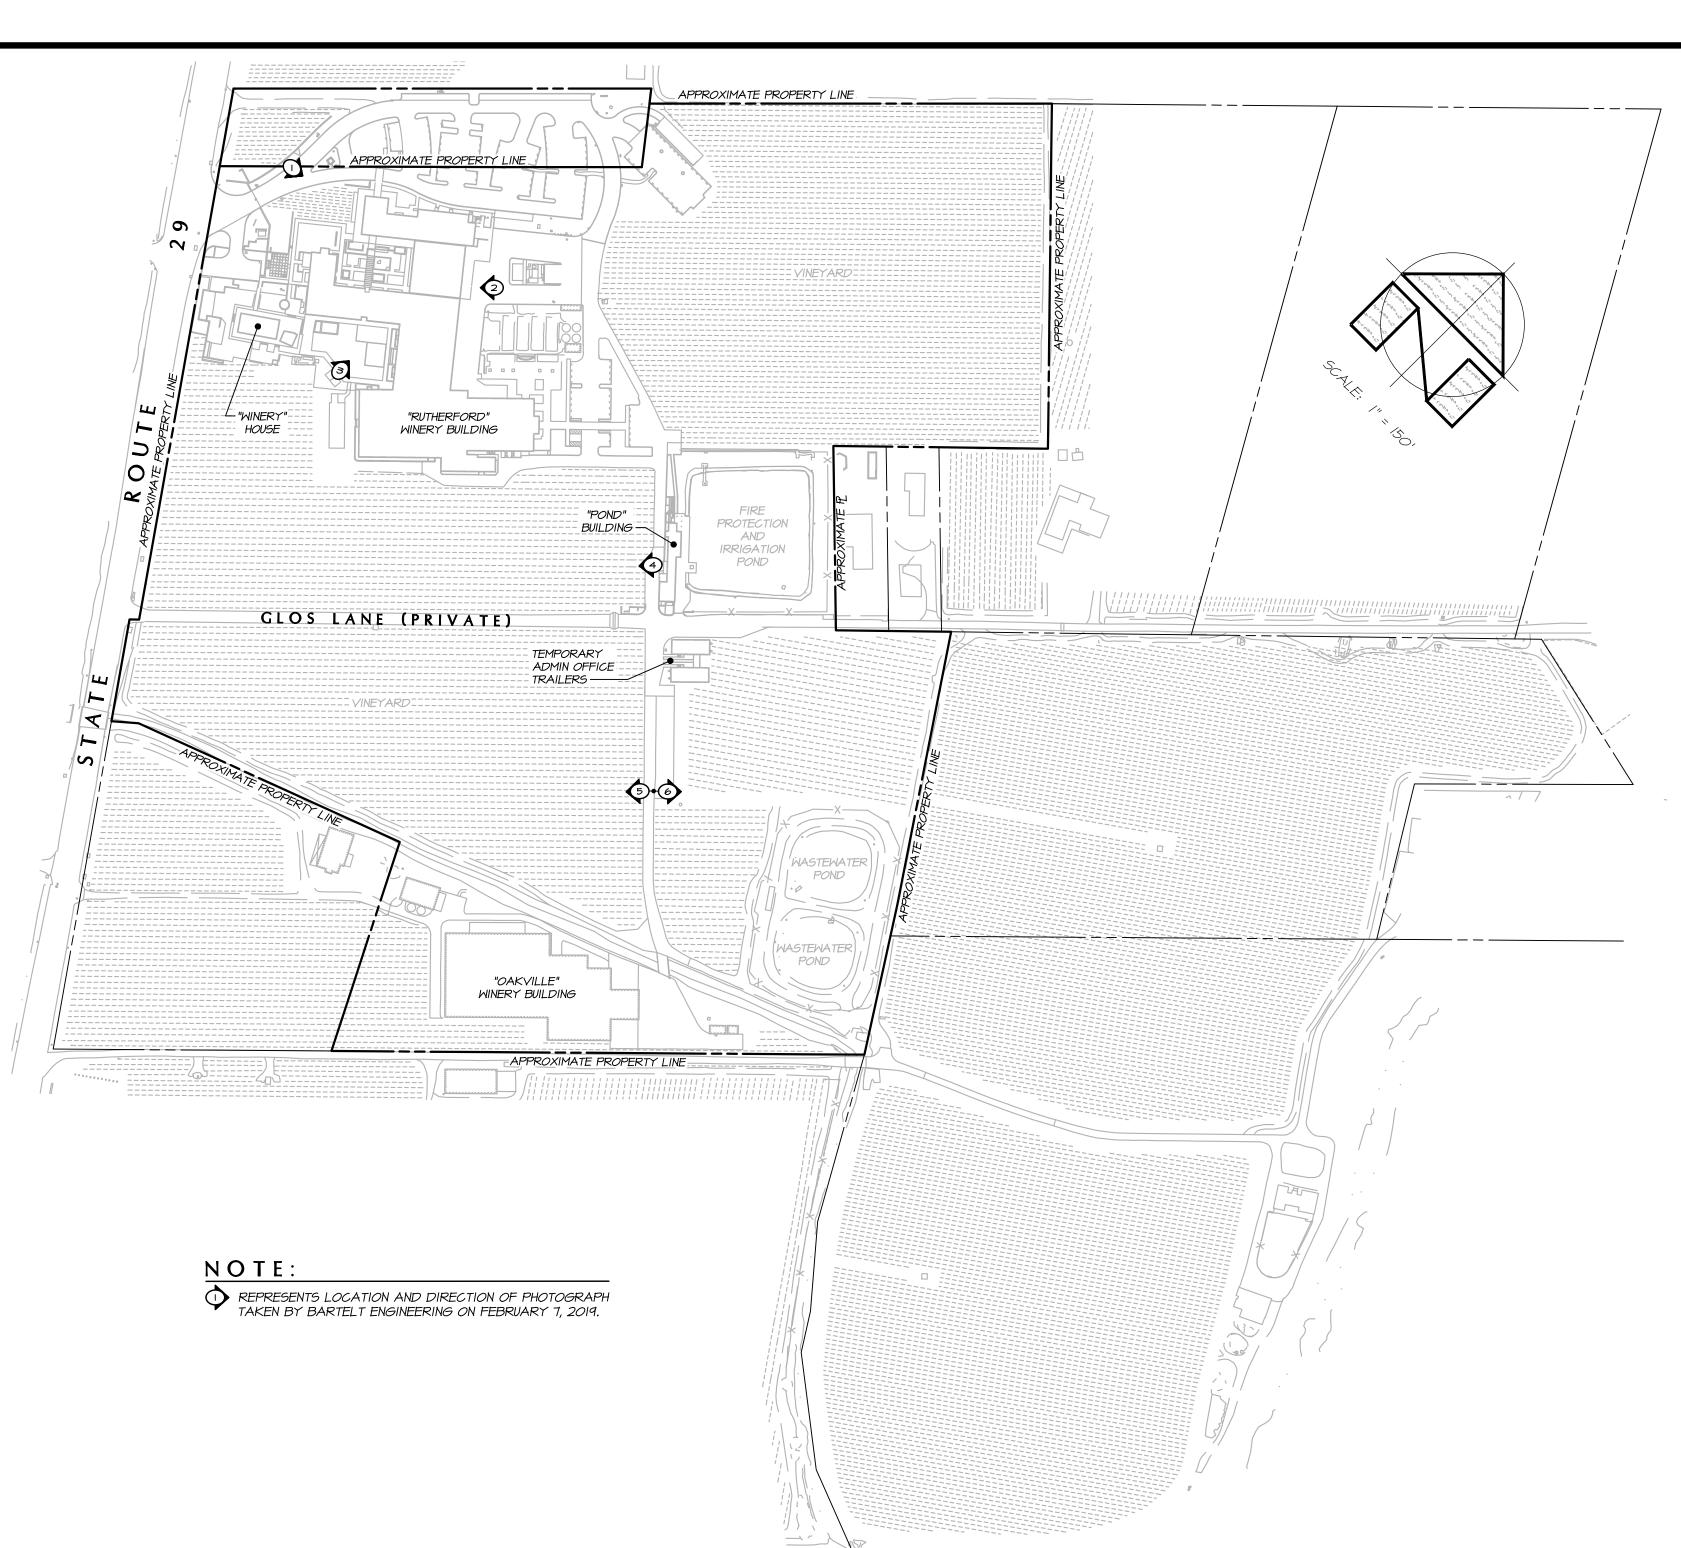

PHOTOGRAPHIC DOCUMENTATION



PHOTOGRAPH 6

NORTHEASTERLY PANORAMIC VIEW OF THE "RUTHERFORD"
WINERY BUILDING, TEMPORARY TRAILERS, VINEYARD, AND THE
"OAKVILLE" WINERY BUILDING

NO	DATE	DESCRIPTION	
\bigwedge	09-10-2019	NO CHANGE TO THIS SHEET	KK
2	02-05-2020	NO CHANGE TO THIS SHEET	KK
\triangle			



PREPARED UNDER THE DIRECTION OF

RICHARD PAXTON R.C.E. 84634


DATE: MARCH 2019


JOB NO: 98-62


SHEET NO:

UP3


OF 9

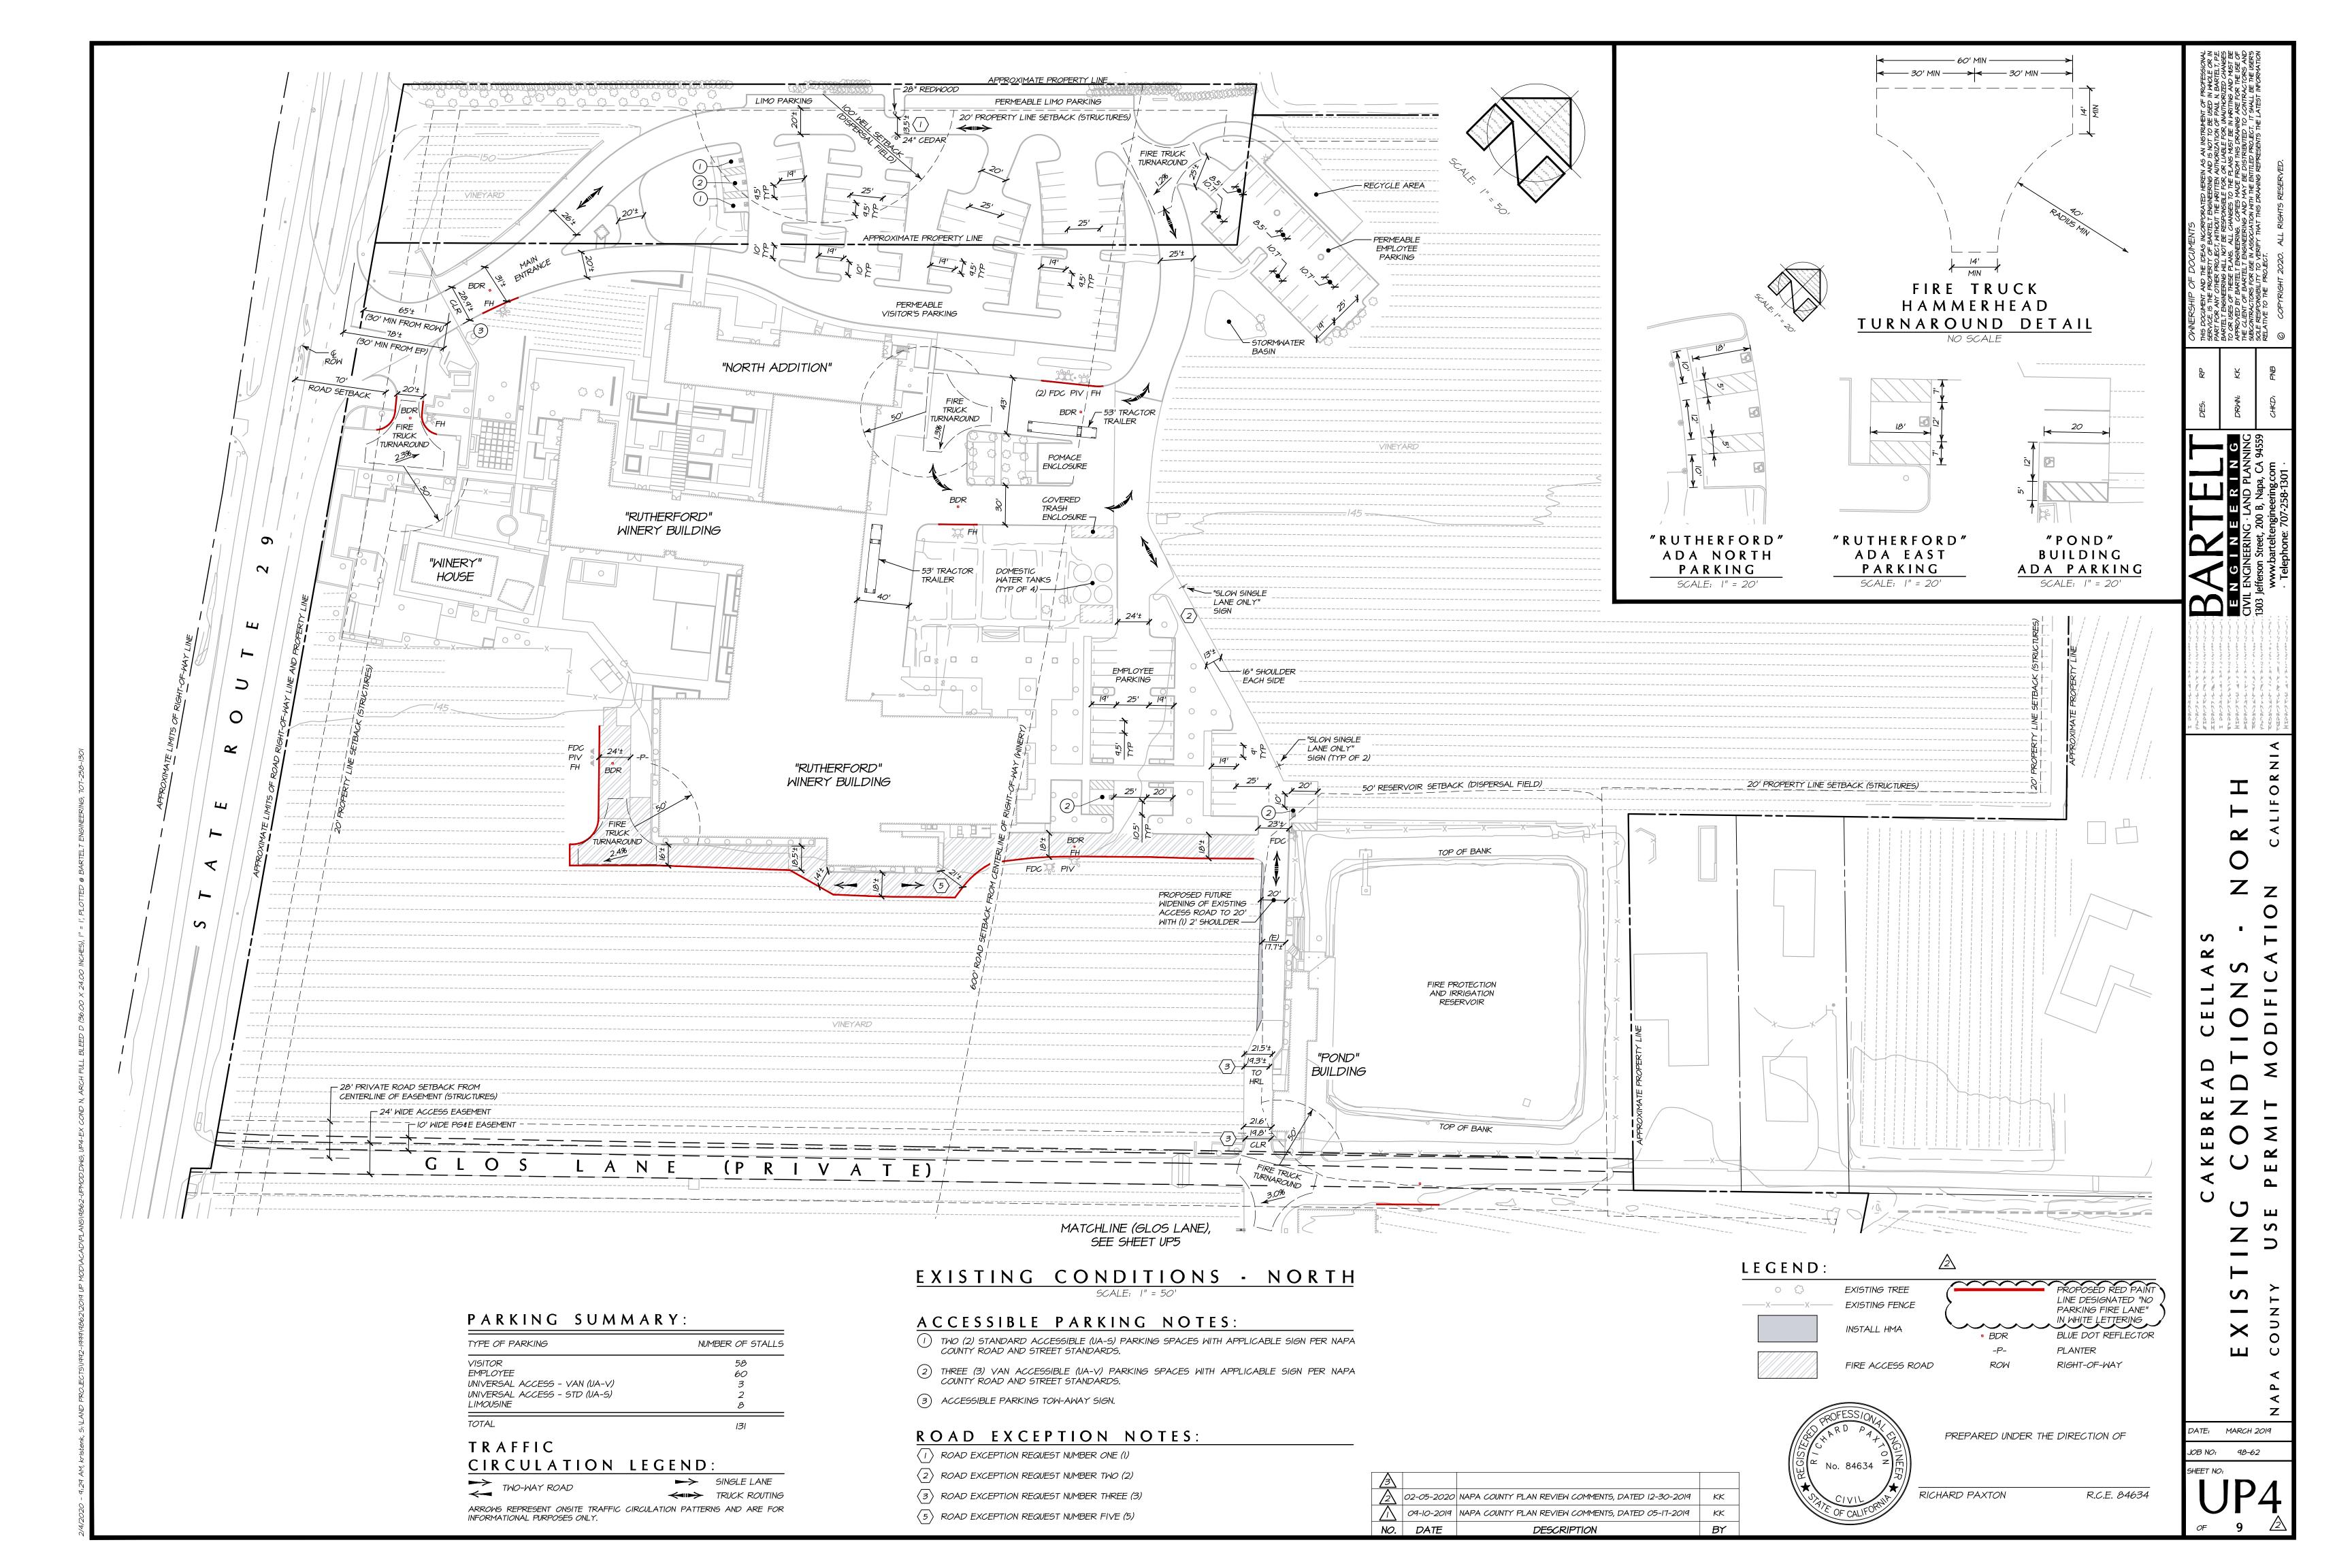

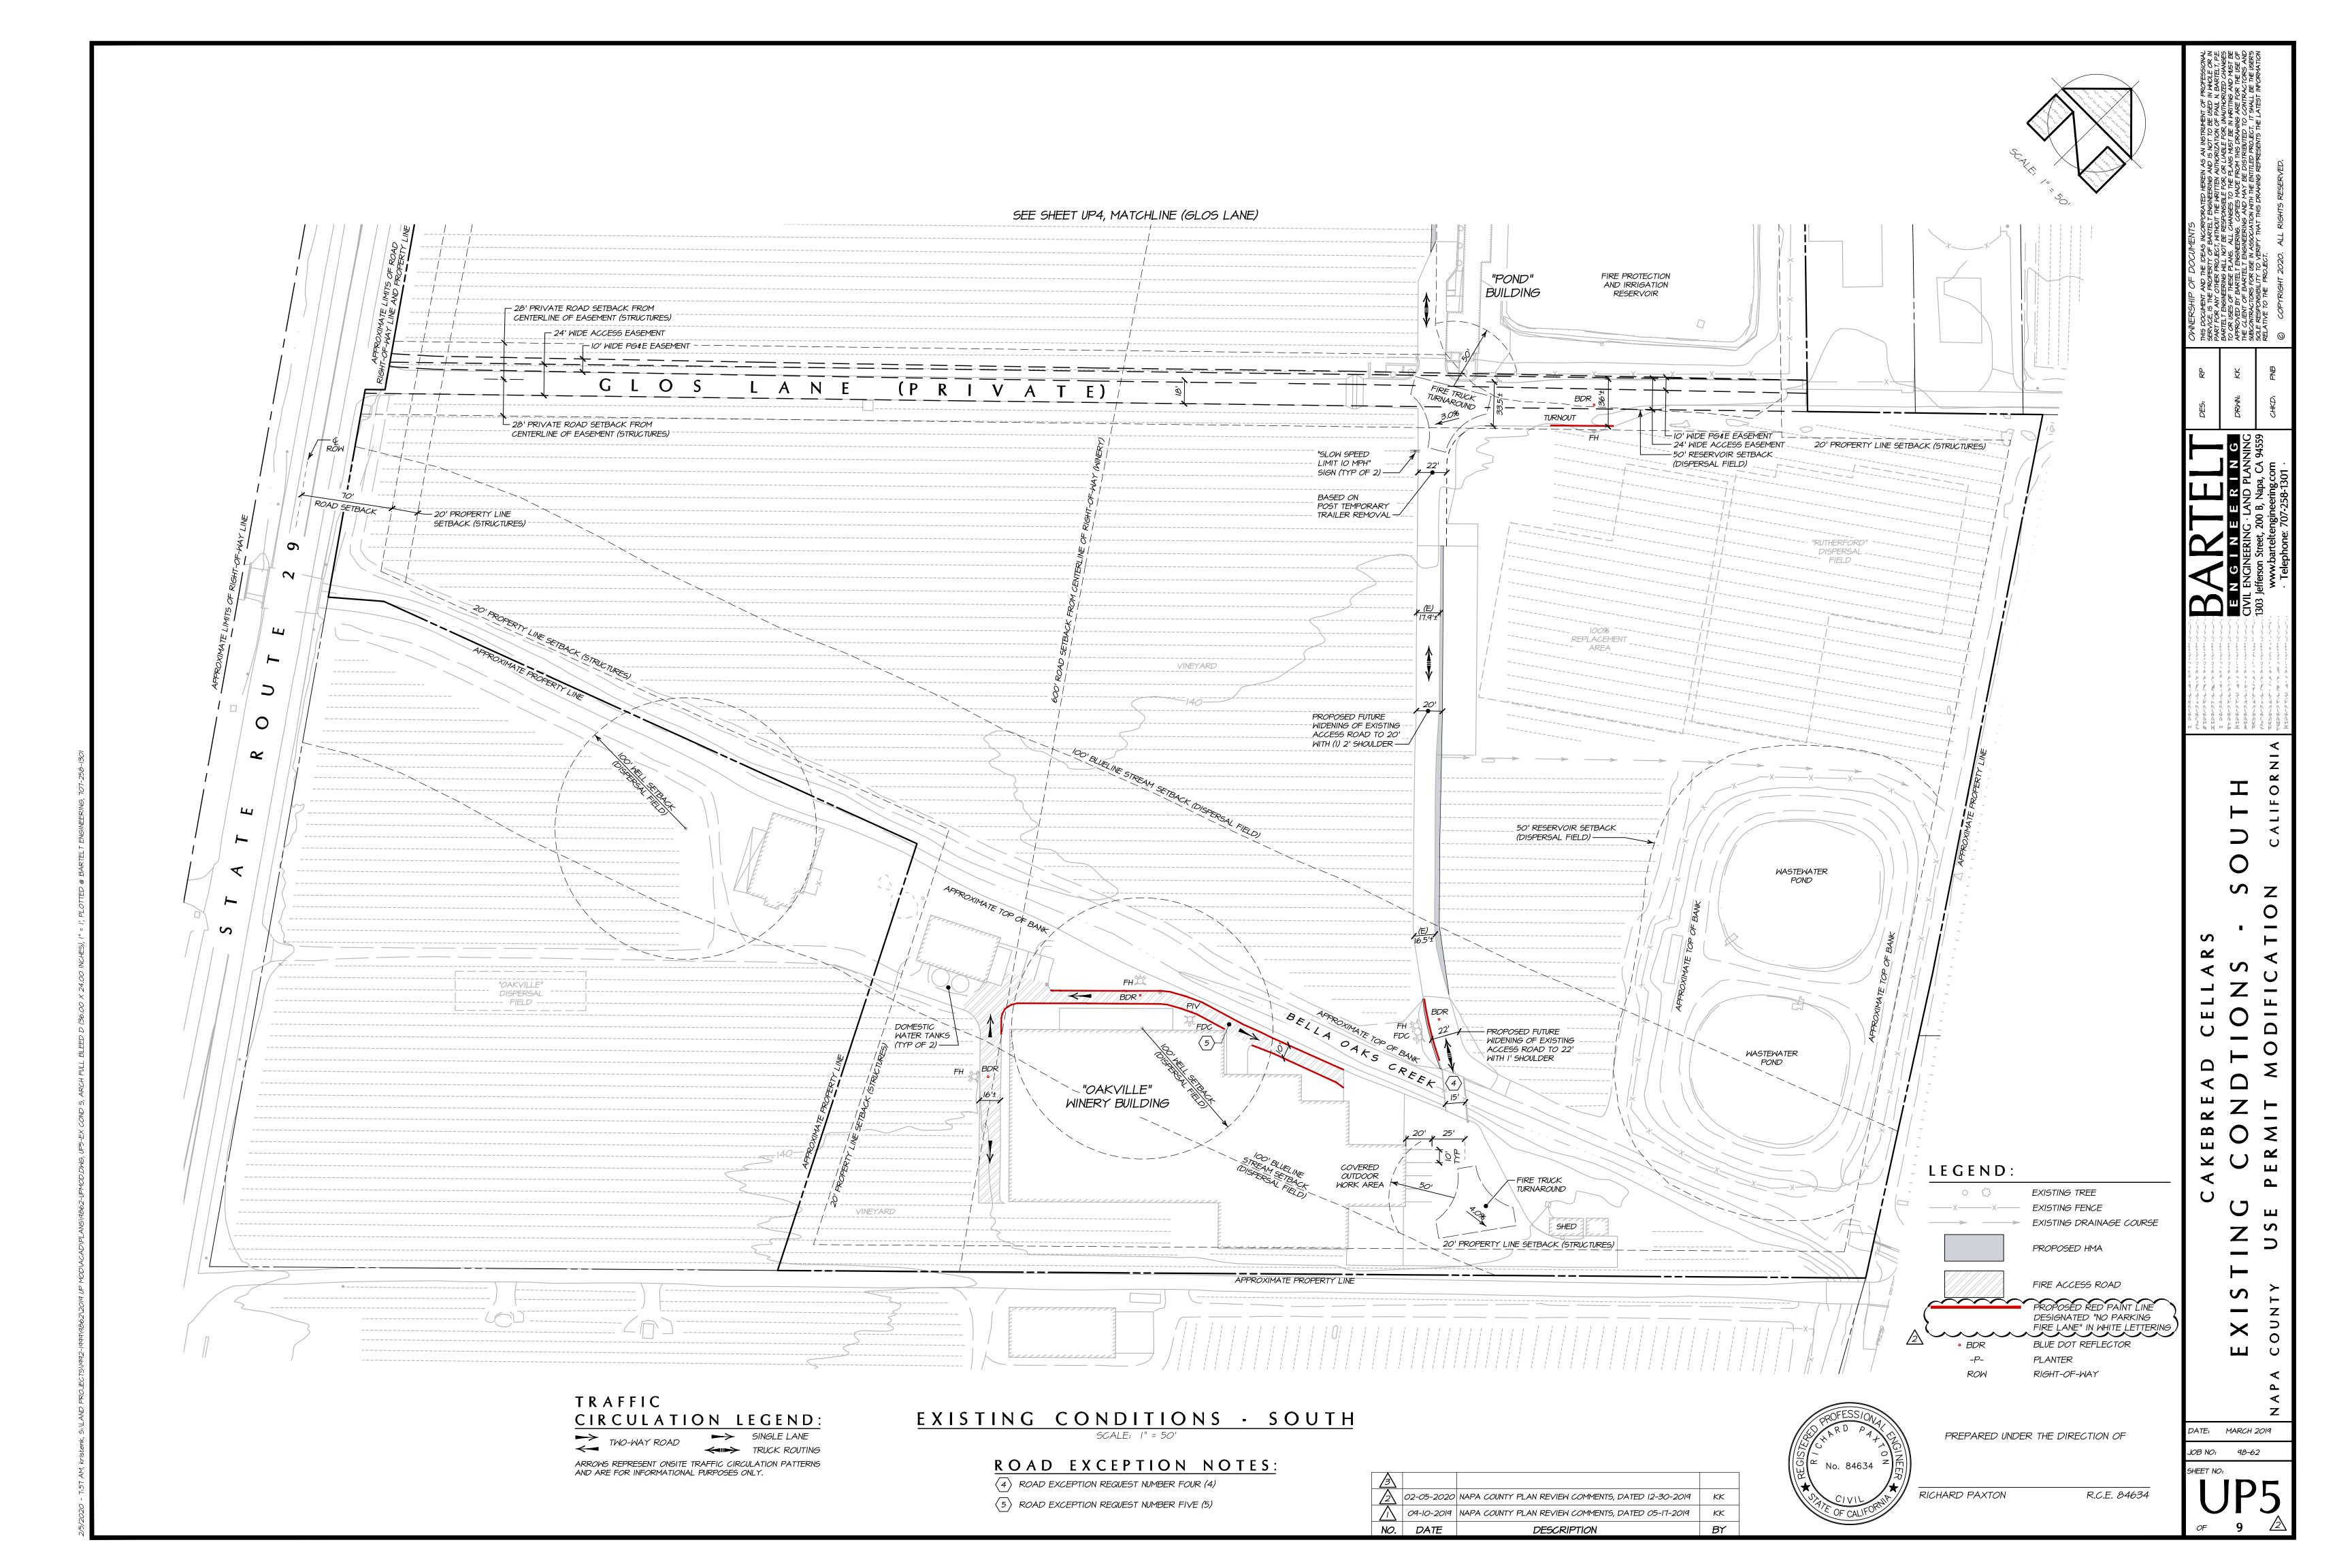

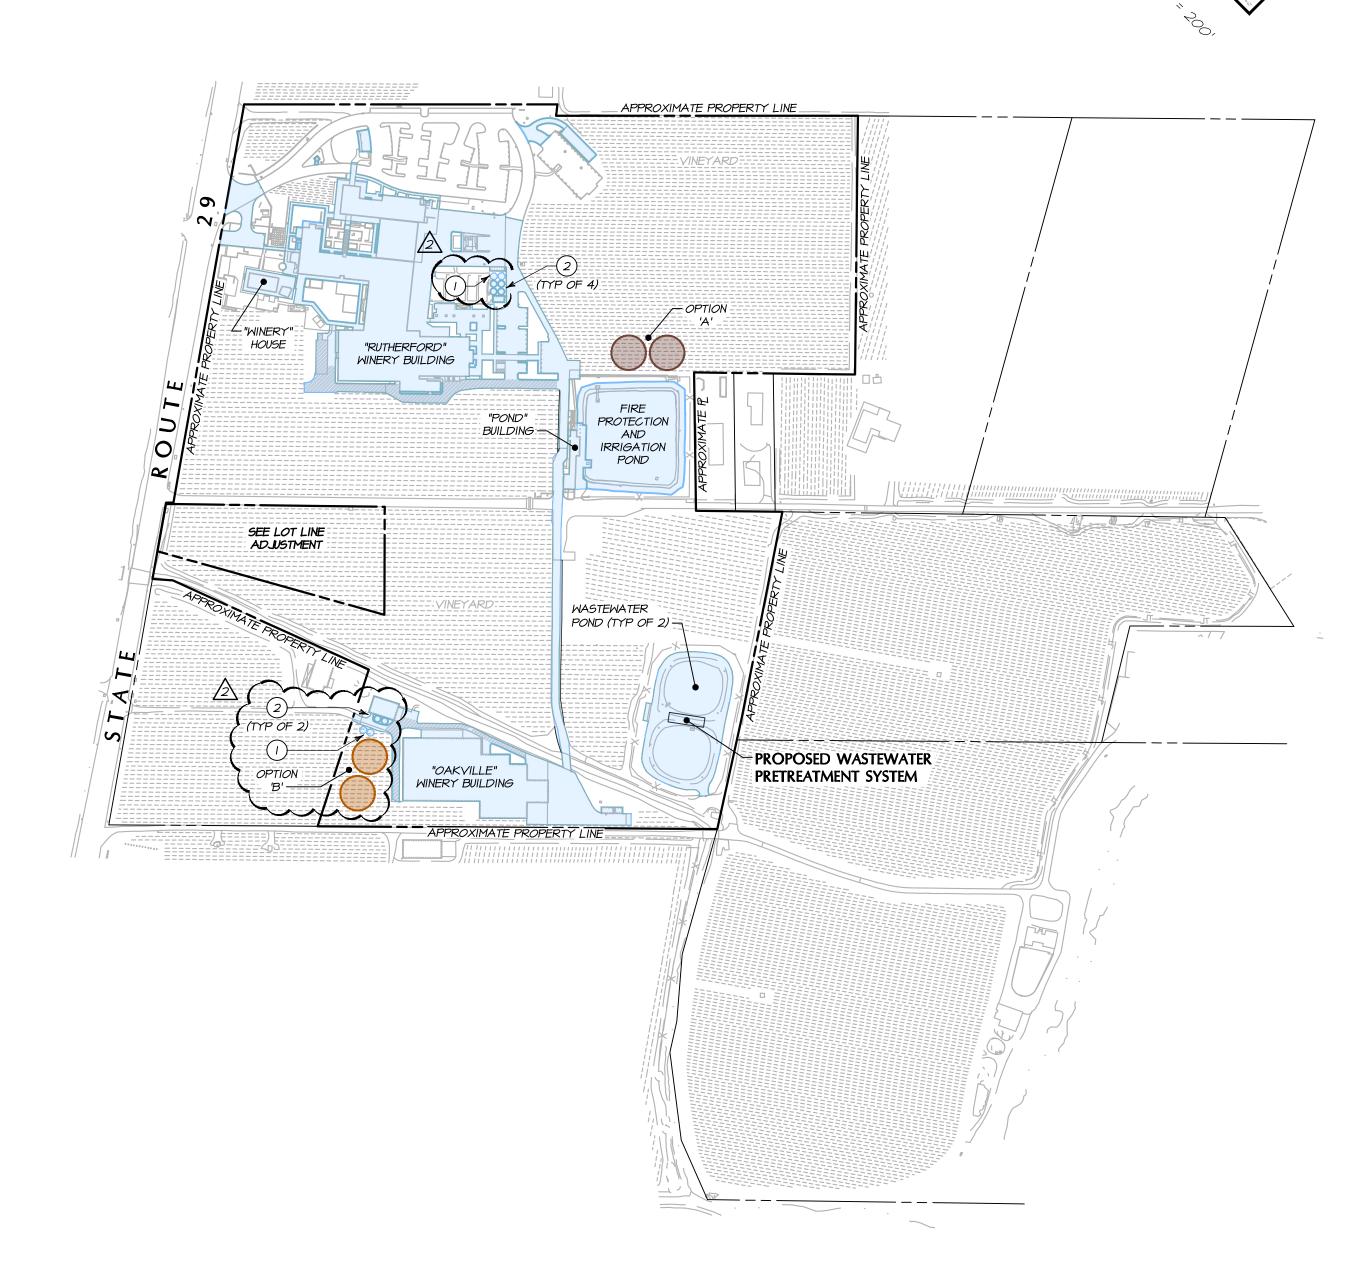

WINERY COVERAGE AREA EXHIBIT PROPOSED CONDITIONS

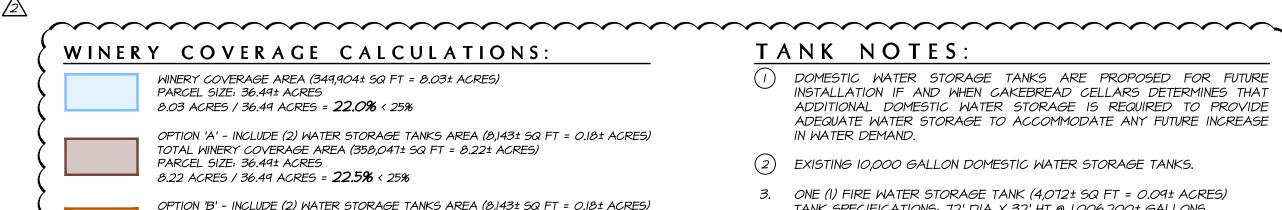

OPTION 'B' - INCLUDE (2) WATER STORAGE TANKS AREA (8,143± 5Q FT = 0.18± ACRES) TOTAL WINERY COVERAGE AREA (358,047± SQ FT = 8.22± ACRES) PARCEL SIZE: 36.49± ACRES 8.22 ACRES / 36.49 ACRES = **22.5%** < 25%

WINERY COVERAGE - THE TOTAL SQUARE FOOT AREA OF ALL WINERY BUILDING FOOTPRINTS, ALL AGGREGATE PAVED OR IMPERVIOUS GROUND SURFACE AREAS OF THE PRODUCTION FACILITY WHICH INCLUDES ALL OUTSIDE WORK, TANK AND STORAGE AREAS (EXCEPT CAVES); ALL PAVED AREAS INCLUDING PARKING AND LOADING AREAS, WALKWAYS AND ACCESS DRIVEWAYS TO PUBLIC OR PRIVATE ROADS OR RIGHTS-OF-WAY; AND ALL ABOVE-GROUND WASTEWATER AND RUN-OFF TREATMENT SYSTEMS. SEE NAPA COUNTY CODE

TANK NOTES:

- DOMESTIC WATER STORAGE TANKS ARE PROPOSED FOR FUTURE INSTALLATION IF AND WHEN CAKEBREAD CELLARS DETERMINES THAT ADDITIONAL DOMESTIC WATER STORAGE IS REQUIRED TO PROVIDE ADEQUATE WATER STORAGE TO ACCOMMODATE ANY FUTURE INCREASE IN WATER DEMAND.
- (2) EXISTING 10,000 GALLON DOMESTIC WATER STORAGE TANKS.
- 3. ONE (1) FIRE WATER STORAGE TANK (4,072± SQ FT = 0.09± ACRES) TANK SPECIFICATIONS: 72' DIA X 32' HT @ 1,006,200± GALLONS.
- 4. ONE (I) DOMESTIC WATER STORAGE TANK (162± SQ FT) TANK SPECIFICATIONS: 13.5' DIA X 14' HT @ 10,000± GALLONS.


2 02-05-2020 NAPA COUNTY PLAN REVIEW COMMENTS, DATED 12-30-2019 O9-10-2019 NAPA COUNTY PLAN REVIEW COMMENTS, DATED 05-17-2019 DESCRIPTION




PREPARED UNDER THE DIRECTION OF

DATE: MARCH 2019 JOB NO: 98-62

RICHARD PAXTON R.C.E. 84634

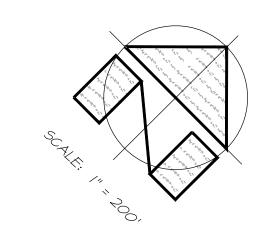

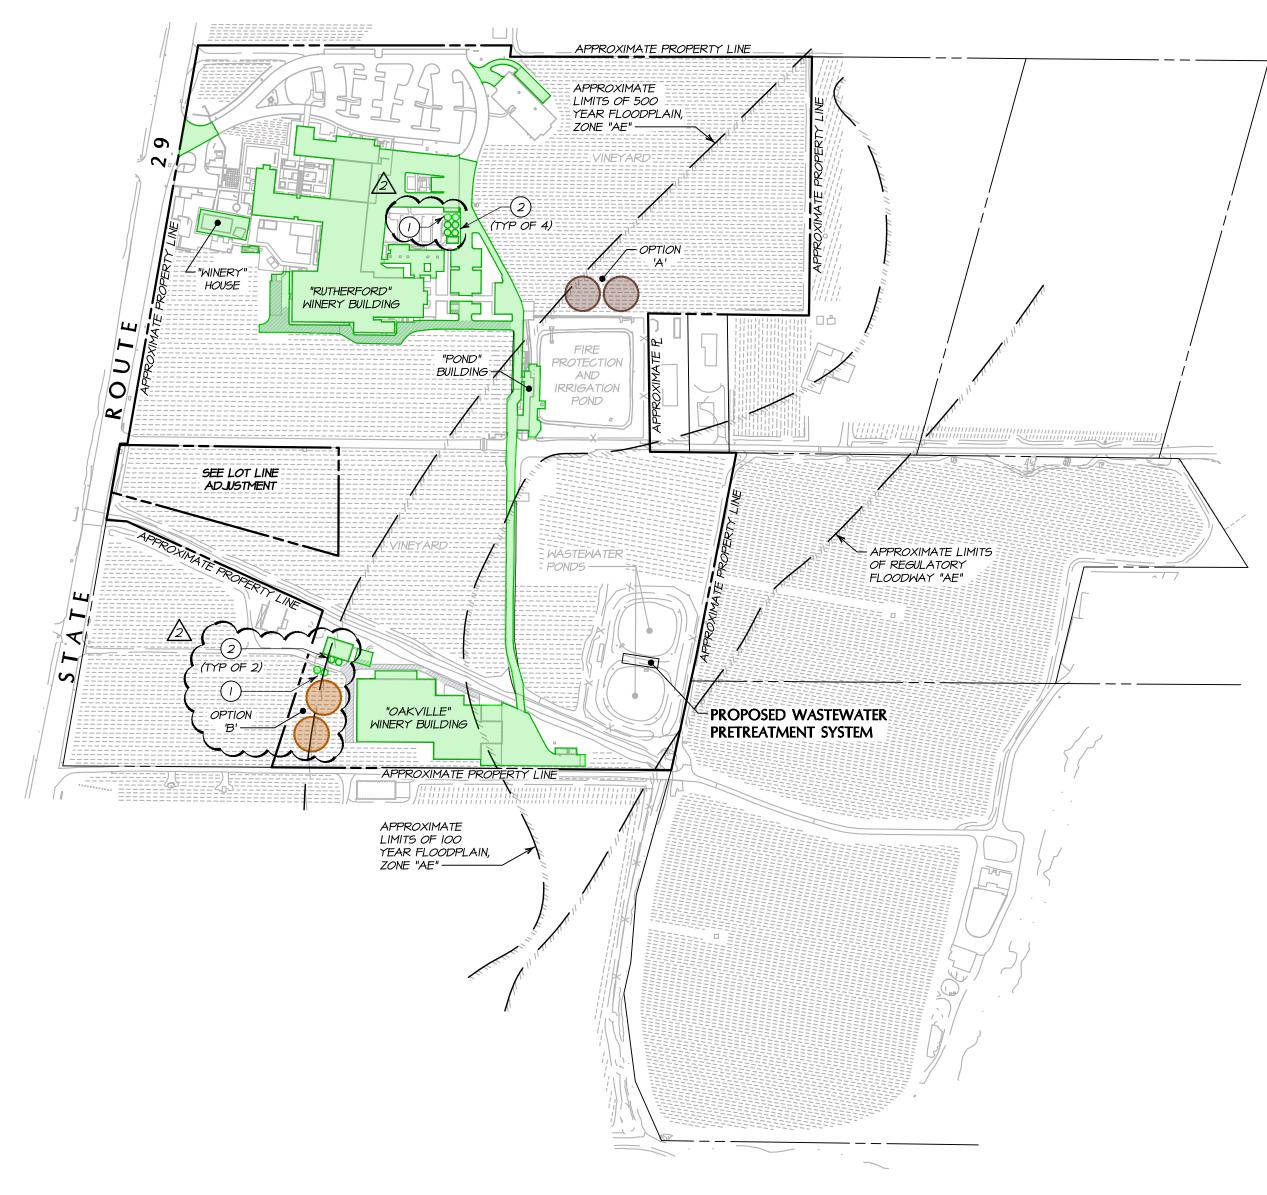


WINERY DEVELOPMENT AREA EXHIBIT PROPOSED CONDITIONS

WINERY DEVELOPMENT AREA: NOTES: (I) DOMESTIC WATER STORAGE TANKS ARE PROPOSED FOR FUTURE WINERY DEVELOPMENT AREA (220,003± SQ FT = 5.05± ACRES) INSTALLATION IF AND WHEN CAKEBREAD CELLARS DETERMINES THAT PARCEL SIZE: 36.49± ACRES ADDITIONAL DOMESTIC WATER STORAGE IS REQUIRED TO PROVIDE ADEQUATE WATER STORAGE TO ACCOMMODATE ANY FUTURE INCREASE IN OPTION 'A' - INCLUDE (2) WATER STORAGE TANKS AREA (8,143± SQ FT = 0.18± ACRES) TOTAL WINERY COVERAGE AREA (228,146± SQ FT = 5.24± ACRES) (2) EXISTING 10,000 GALLON DOMESTIC WATER STORAGE TANKS. OPTION 'B' - INCLUDE (2) WATER STORAGE TANKS AREA (8,143± SQ FT = 0.18± ACRES) TOTAL WINERY COVERAGE AREA (228,146± SQ FT = 5.24± ACRES) WINERY DEVELOPMENT AREA - ALL AGGREGATE PAVED OR IMPERVIOUS OR SEMI-PERMEABLE GROUND SURFACE AREAS OF THE PRODUCTION FACILITY WHICH INCLUDES ALL STORAGE AREAS (EXCEPT CAVES), OFFICES, LABORATORIES, KITCHENS, TASTING ROOMS AND PAVED PARKING AREAS FOR THE EXCLUSIVE USE OF WINERY EMPLOYEES. SEE NAPA COUNTY CODE SIB:104.210

DESCRIPTION

NO. DATE

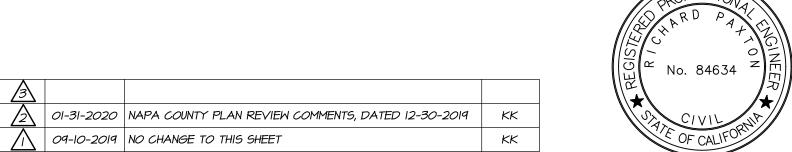

BY





PREPARED UNDER THE DIRECTION OF

RICHARD PAXTON R.C.E. 84634

DATE: MARCH 2019 JOB NO: 98-62

S

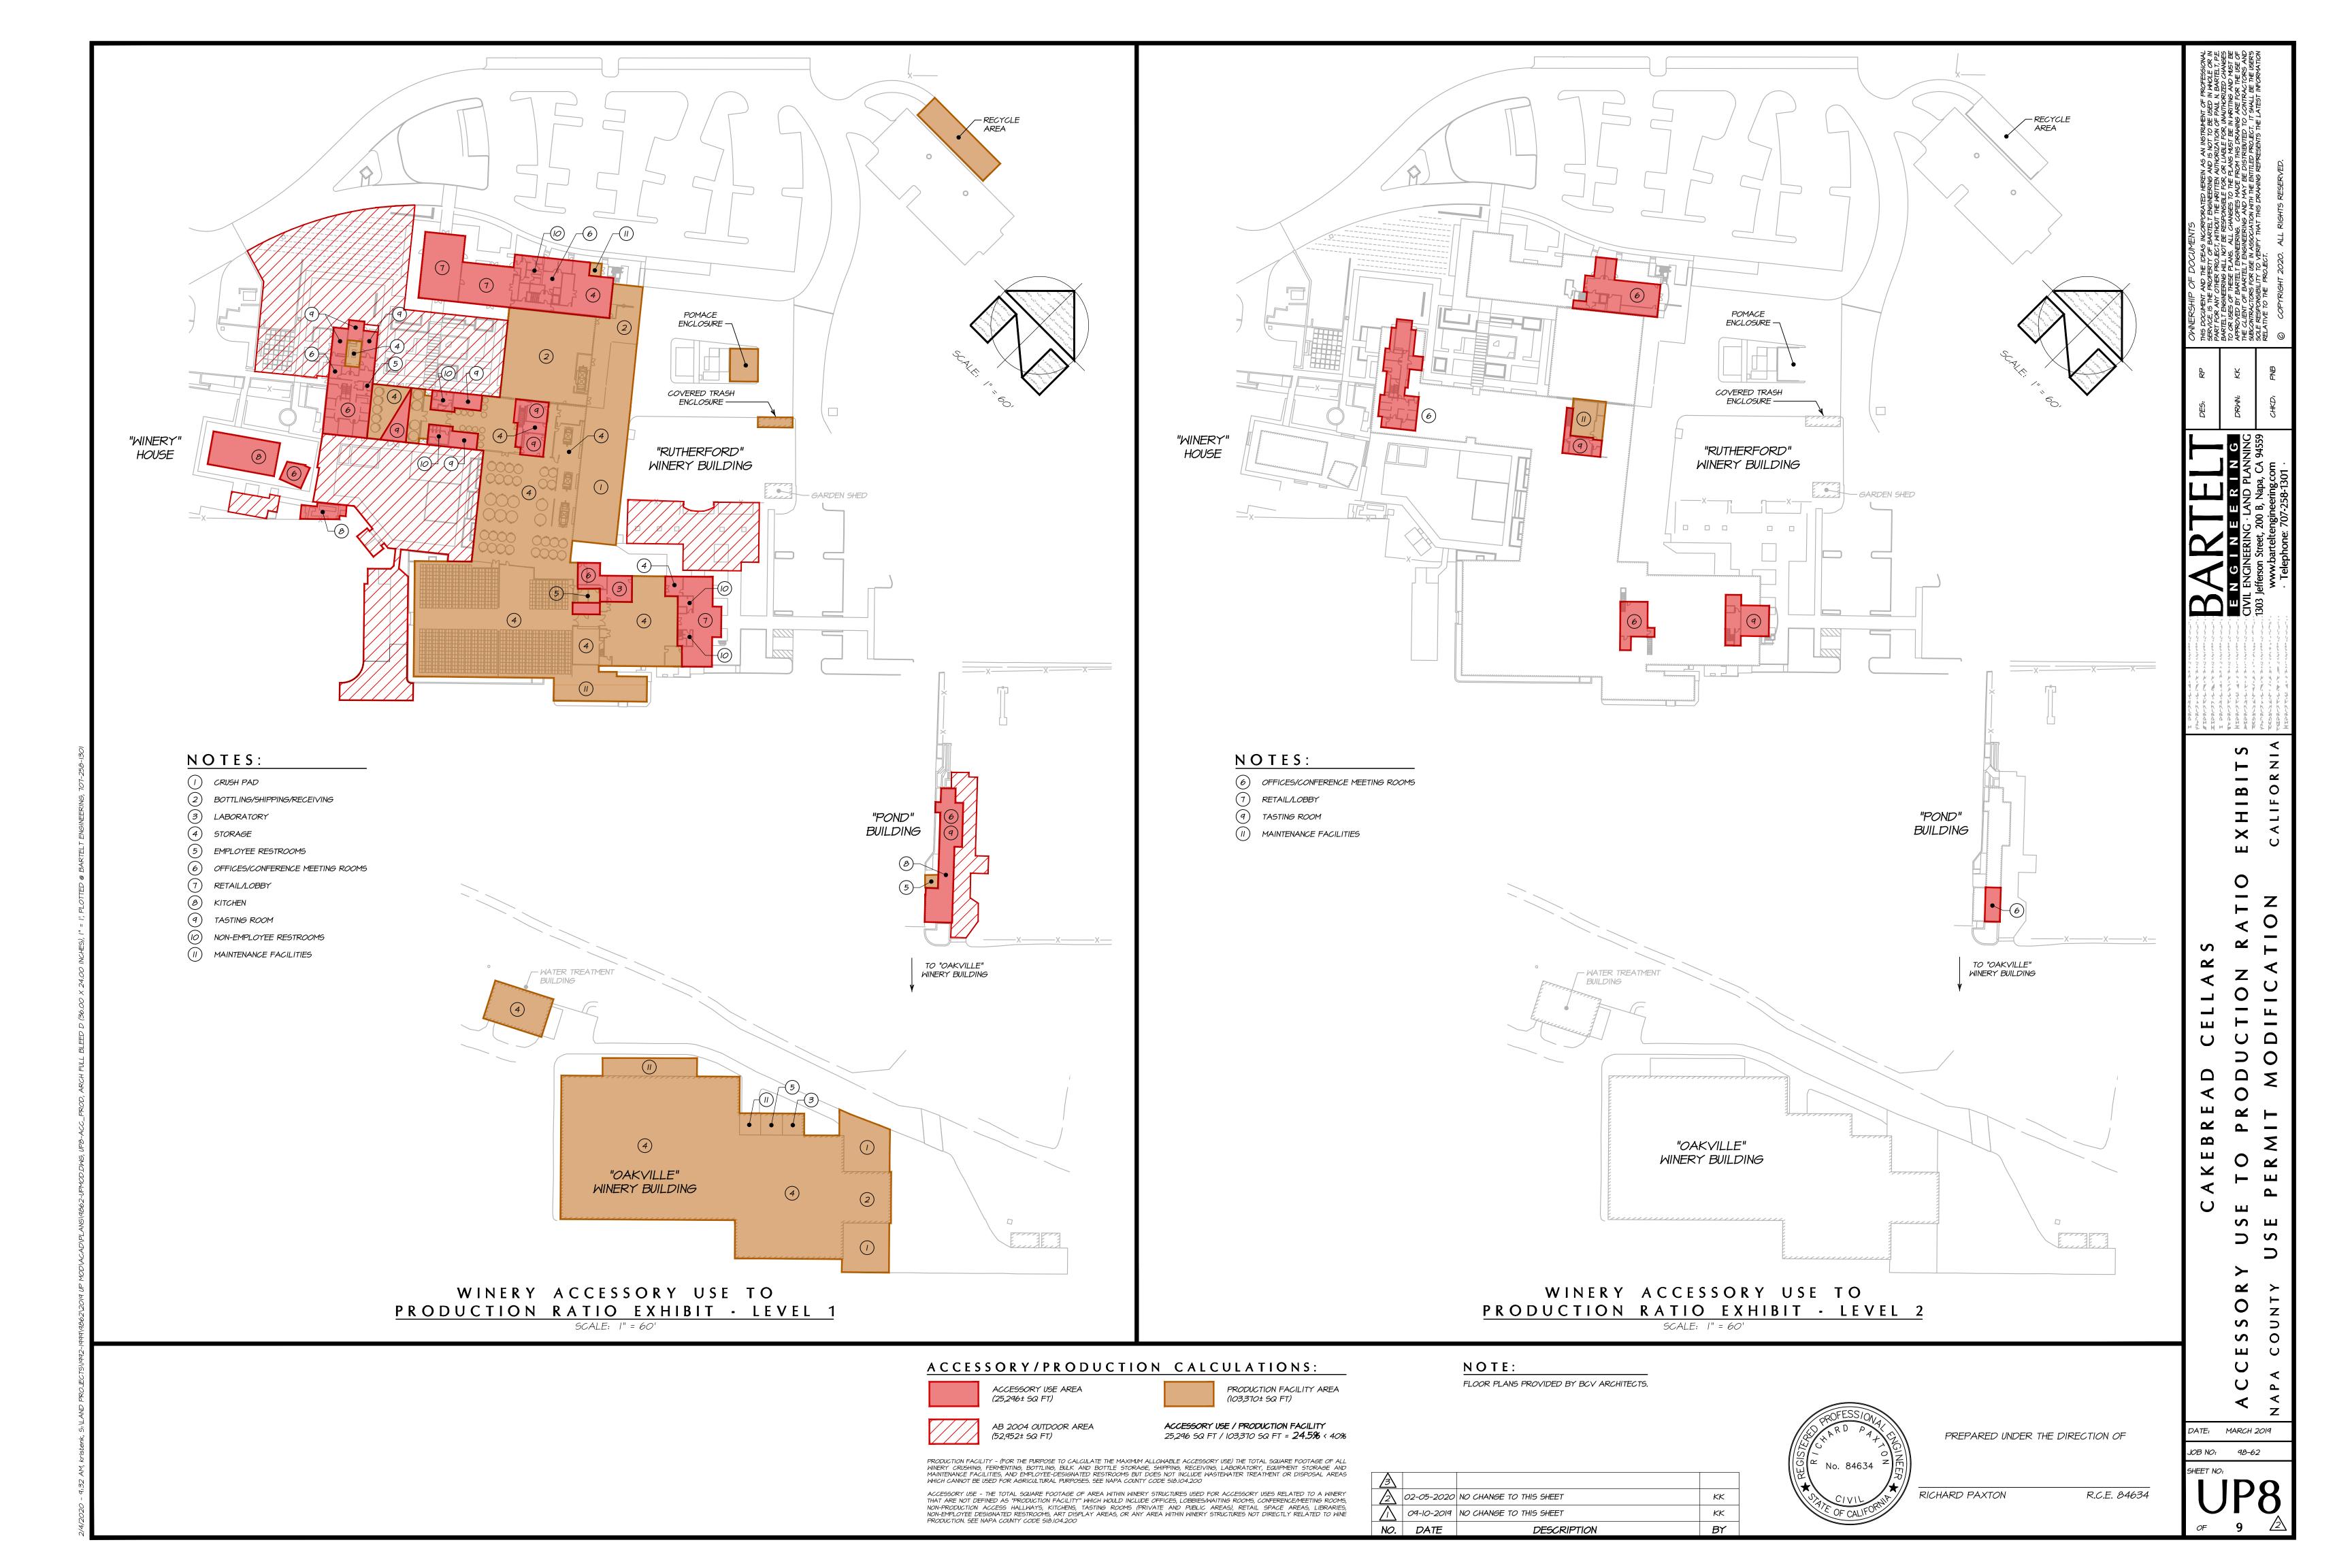

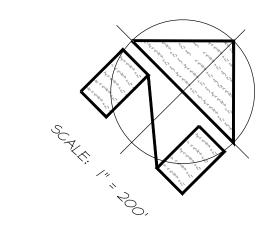



IMPERVIOUS AREA EXHIBIT PROPOSED CONDITIONS

TANK NOTES: LEGEND: DOMESTIC WATER STORAGE TANKS ARE PROPOSED FOR FUTURE PROPOSED IMPERVIOUS AREA (361,731± SQ FT = 8.30± ACRES) PARCEL SIZE: 36.49± ACRES INSTALLATION IF AND WHEN CAKEBREAD CELLARS DETERMINES THAT ADDITIONAL DOMESTIC WATER STORAGE IS REQUIRED TO PROVIDE ADEQUATE WATER STORAGE TO ACCOMMODATE ANY FUTURE INCREASE OPTION 'A' - INCLUDE (2) FIRE WATER STORAGE TANKS AREA (8,143± SQ FT = 0.18± ACRES) TOTAL IMPERVIOUS AREA (369,874± SQ FT = 8.49± ACRES) PARCEL SIZE: 36.49± ACRES 2 EXISTING 10,000 GALLON DOMESTIC WATER STORAGE TANKS. OPTION 'B' - INCLUDE (2) FIRE WATER STORAGE TANKS AREA (8,143± SQ FT = 0.18± ACRES) TOTAL IMPERVIOUS AREA (369,874± SQ FT = 8.49± ACRES) ONE (I) FIRE WATER STORAGE TANK (4,072± SQ FT = 0.09± ACRES) TANK SPECIFICATIONS: 72' DIA X 32' HT @ 1,006,200± GALLONS. PARCEL SIZE: 36.49± ACRES 4. ONE (I) DOMESTIC WATER STORAGE TANK (162± SQ FT) TANK SPECIFICATIONS: 13.5' DIA X 14' HT @ 10,000 + GALLONS.



PREPARED UNDER THE DIRECTION OF

RICHARD PAXTON

JOB NO: 98-62 R.C.E. 84634

DATE: MARCH 2019

02-05-2020 NAPA COUNTY PLAN REVIEW COMMENTS, DATED 12-30-2019 09-10-2019 NAPA COUNTY PLAN REVIEW COMMENTS, DATED 05-17-2019 DESCRIPTION